


7  
G 3034  
34387  
35094  
75737

# T.4N.R.28E.W.M.

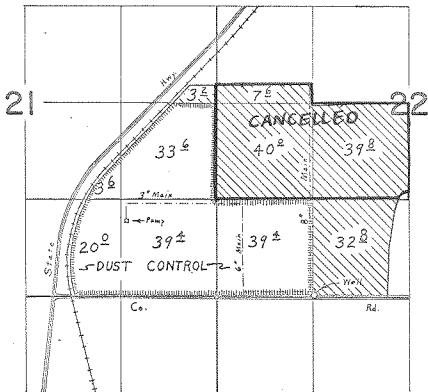

## FINAL PROOF SURVEY UNDER

Application No. G-3225 Permit No. G-3034  
IN NAME OF

C. & B. LIVESTOCK, INC.

Surveyed Aug. 9, 1966, by L. E. Gould