


G-9233 12  
T8005  
53455  
75740  
T8005

# T.26S.,R.18E.,W.M.

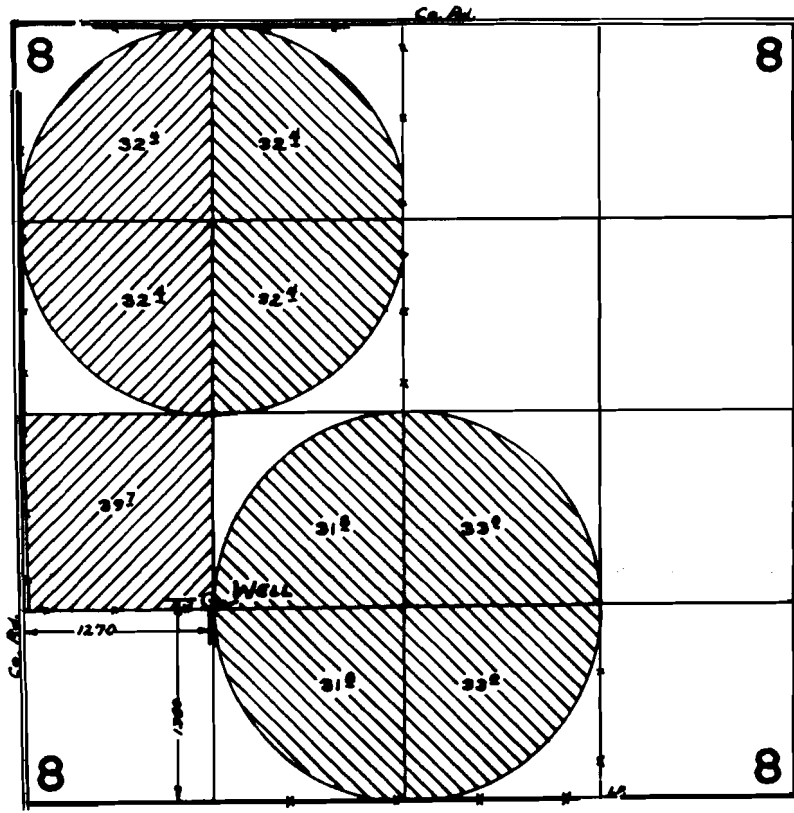

## FINAL PROOF SURVEY UNDER

Application No. G-9792 Permit No. G-8876  
G-10173 G-9233 

IN NAME OF

FRED G. CROUCH

Surveyed OCT. 26. 1981., by L. J. TOLL