


T. 37 S., R. 6 W., W.M.

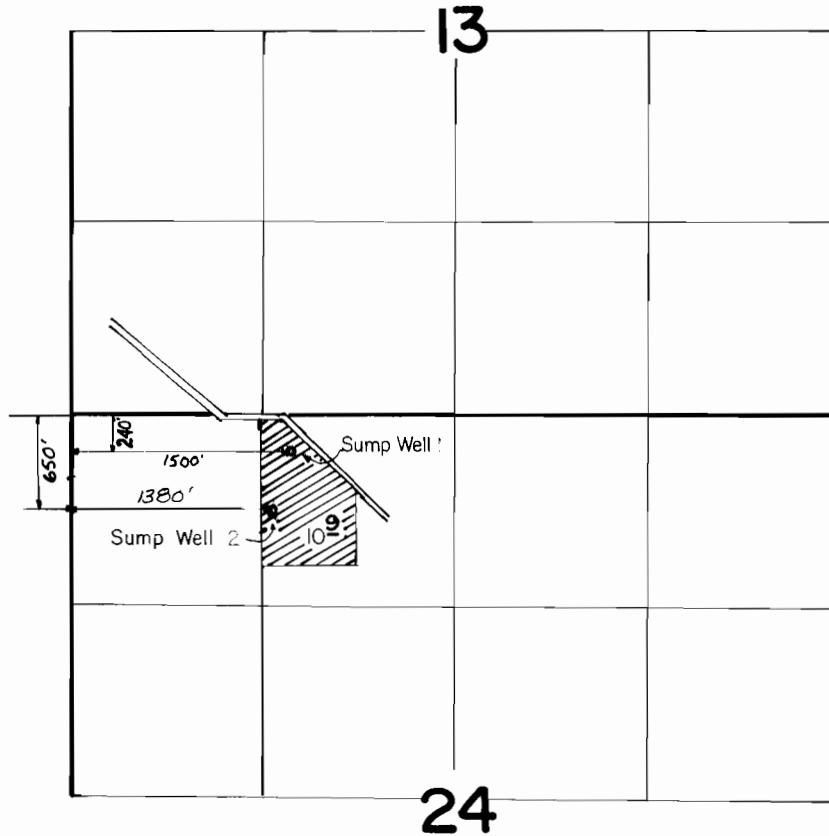

FINAL PROOF SURVEY
UNDER

Application No. ..G.9699. Permit No. G.9652.....
IN NAME OF

MICHAEL R. GALLAGHER

Surveyed ..OCT. 4, 1983., by ..B.S. JAMES.....