


T. 16 S., R. 43 E., W.M.

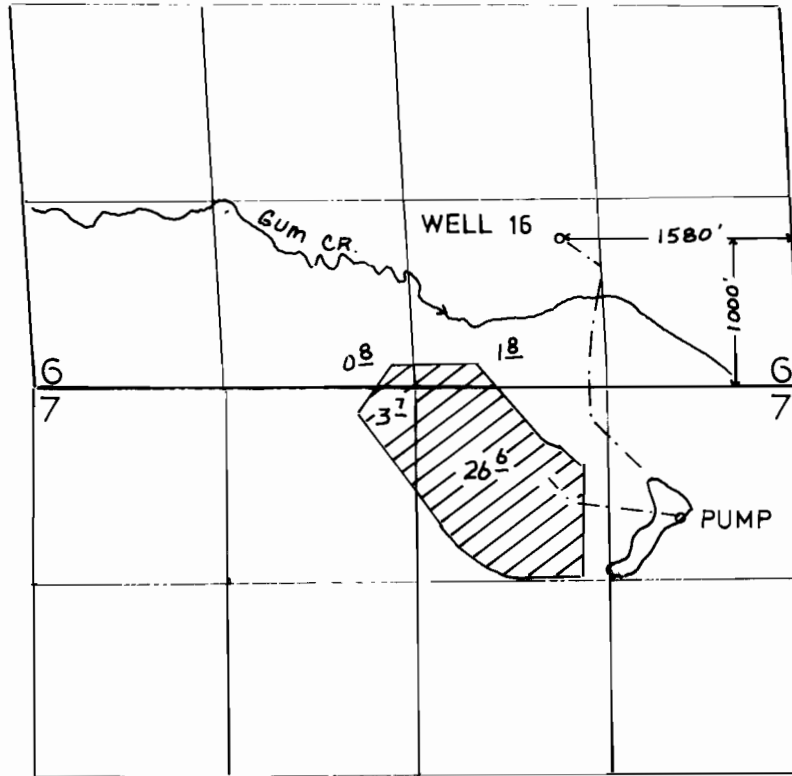

## FINAL PROOF SURVEY

UNDER

Application No. G-10144 Permit No. G10459  
IN NAME OF

GUM CREEK FARMS

Surveyed 7-31, 1992, by J. MILLER