



T. 4 S., R. 16 E. W. M.

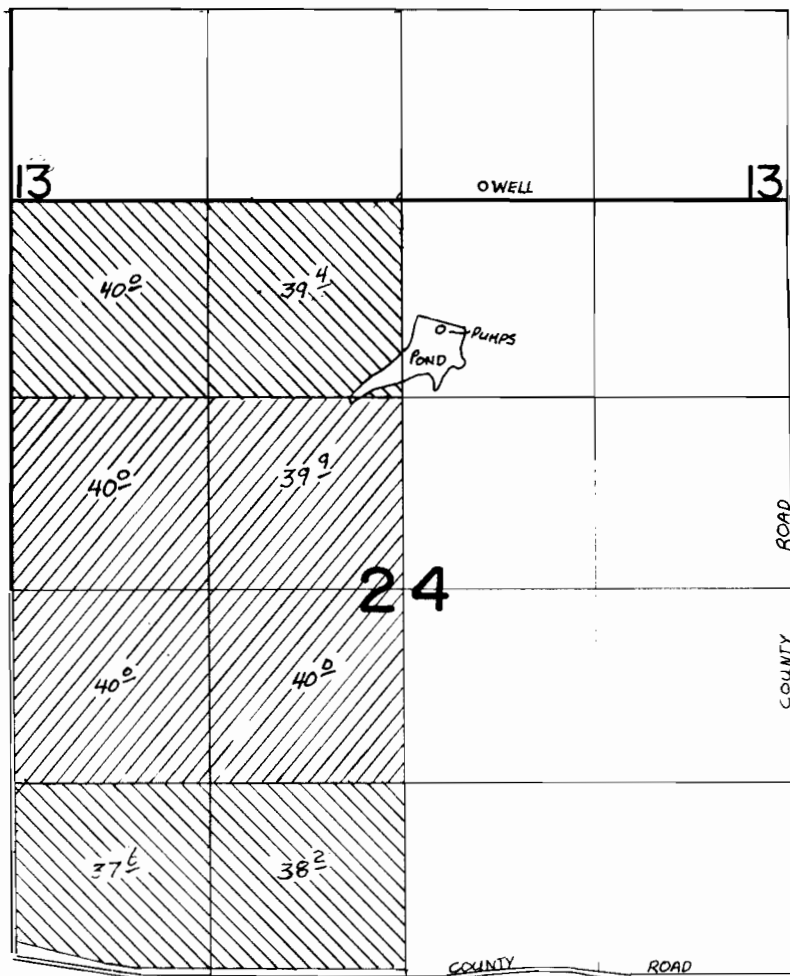

WELL LOCATED 100' N. AND 550' EAST FROM S 1/4 COR. SEC. 13

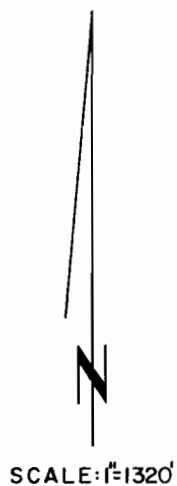

PER. G-9218



PER. G-10004

FINAL PROOF SURVEY

UNDER

G-10170 G-9218
 Application No. G-10835 Permit No. G-10004
 IN NAME OF

CARL H. VONBORSTEL

Surveyed MAY 6, 1985, by V.L. CHURCH