


Original maps & field forms
in file 64886
COPY

T4S., R16E, WM.

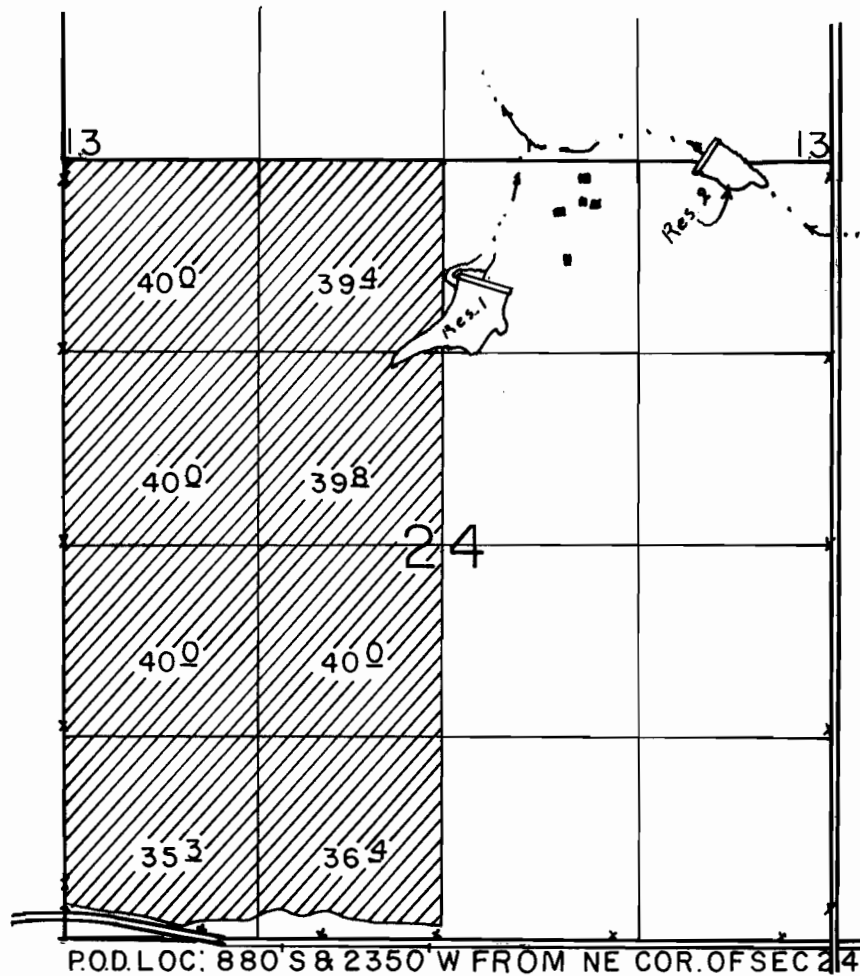

SCALE: 1" = 1320'

FINAL PROOF SURVEY UNDER

Application No. 64886 Permit No. 47371
R-64885 R-8600

IN NAME OF

CARL VONBORSTEL

Surveyed AUG 15 1995, by R.M. SUTTERFIELD