


T.28S., R.14W., W.M.

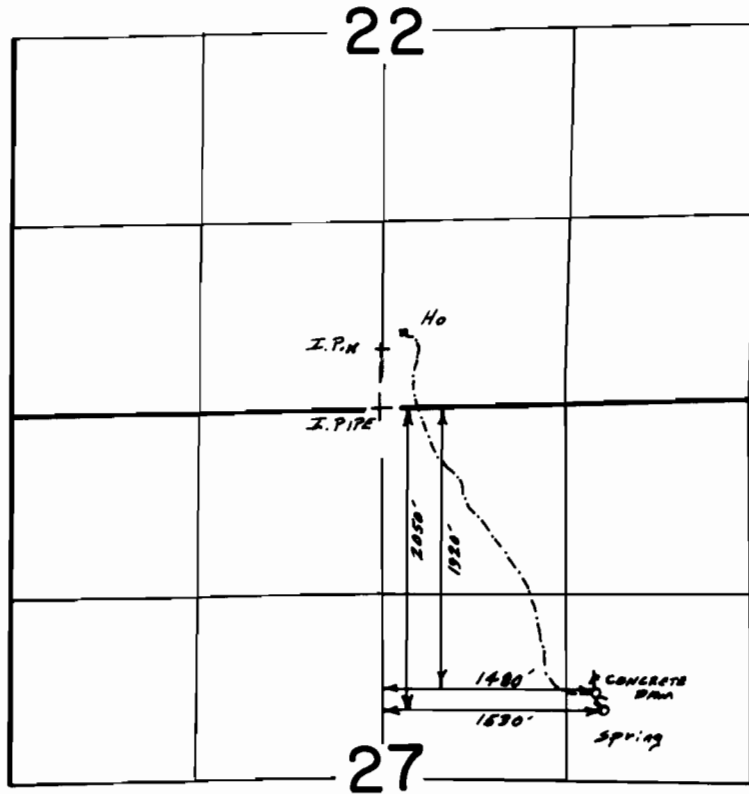

Scale 1"=1320'



**FINAL PROOF SURVEY**  
UNDER

Application No. 55205 Permit No. 41466....  
IN NAME OF

*Richard & Donna Rayburn*

Surveyed Oct. 29, 1991., by B.S. JAMES.....