


T.3S. R.16E.,W.M

N
↑
1" = 1320'

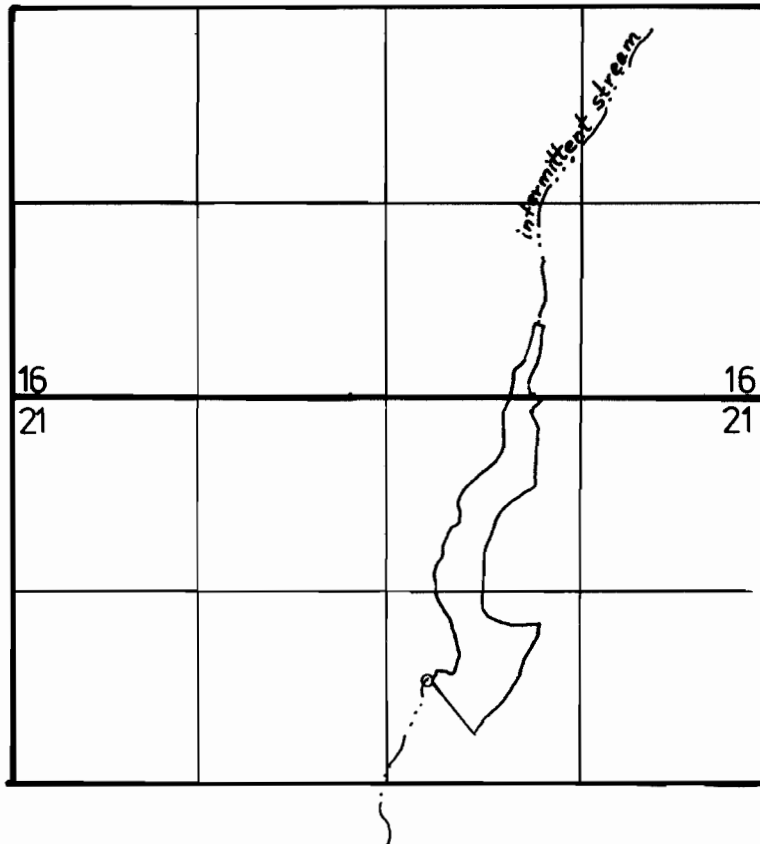

POD 700 feet North and 2300 feet West from the
East 1/4 Corner of Section 21, T 3 S. R 16 E. W.M.

FINAL PROOF SURVEY UNDER

R-65303 R 8807
Application No. 65304... Permit No. 47686.....
IN NAME OF

.....FRED. A. JUSTESEN.....

Surveyed 6-27..... 1991.., by J. MILLER, L. TOLL.