


Point of diversion is 30 ft. North  
& 980 ft. West of the east 1/4  
corner of Section 9.

**FINAL PROOF SURVEY OF A  
PERMIT TO APPROPRIATE SURFACE WATER  
IN THE SE 1/4 NE 1/4 & THE NE 1/4 SE 1/4 OF  
SECTION 9, T26S, R3W, W.M., DOUGLAS  
COUNTY, OREGON**

Application No. S-73811  
Permit No. 51794

For: Patrick G. & Rebecca Sue McRae  
13570 SW Feiring Lane  
Tigard, Oregon 97223

By: Shaner Engineering, Inc.  
P. O. Box 1430  
Roseburg, Oregon 97470

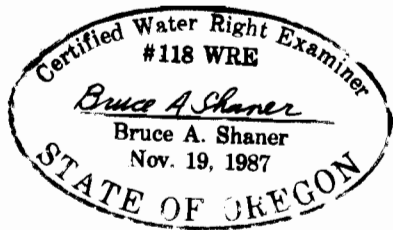

Scale: 1" = 200 ft.

October 11, 1996