


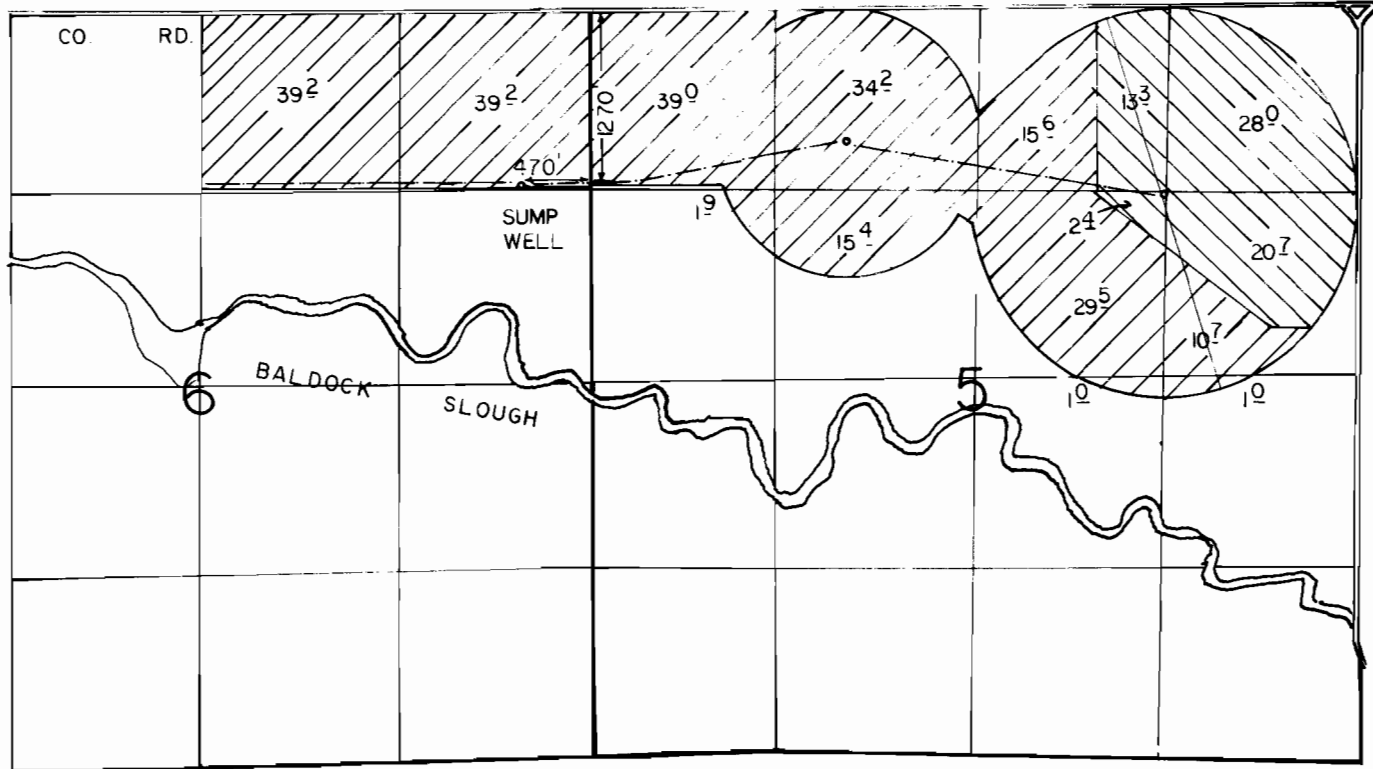

T. 8 S., R. 40 E., W.M.



1" = 1320'

 A " 20705 , C " 52008 (PRI)
 A " 46642 , C " 52324 (SUP)

FINAL PROOF SURVEY UNDER

Application No. G-10138 Permit No. G-9380
 IN NAME OF

LAZY J. RANCH, INC.

Surveyed AUG. 8 19⁹⁰, by K. KEMP

5-21-91 *DSM*
 41001-279-72 R