


T. 3 N. R. 26 E. W. M.

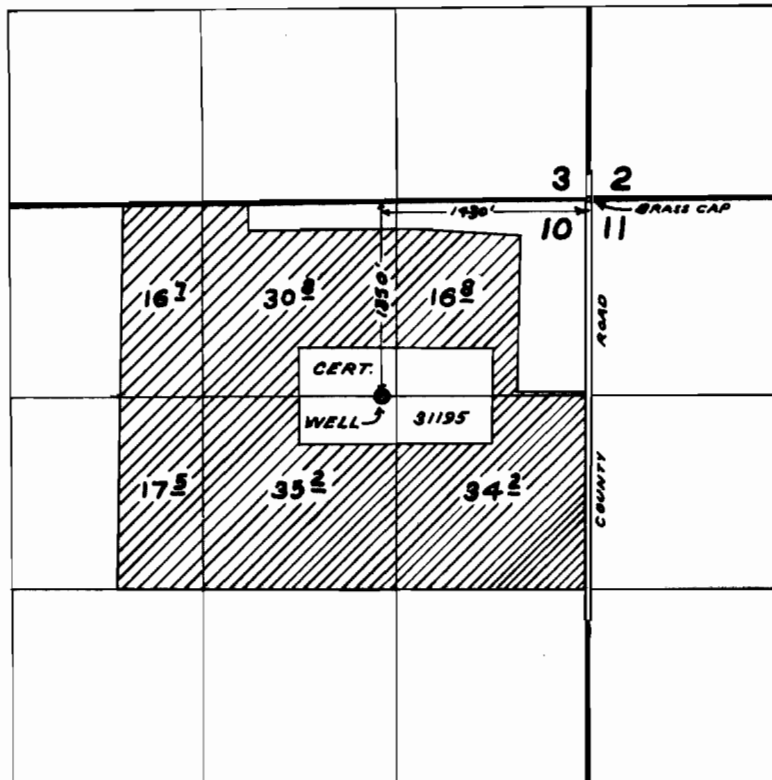

FINAL PROOF SURVEY UNDER

Application No. G-1224 Permit No. G-1070

IN NAME OF

WALDO H. CRAMER

Surveyed AUG. 3 1966, by L. GOULD