


T.5 S.R.18 & 2 E.W.M.

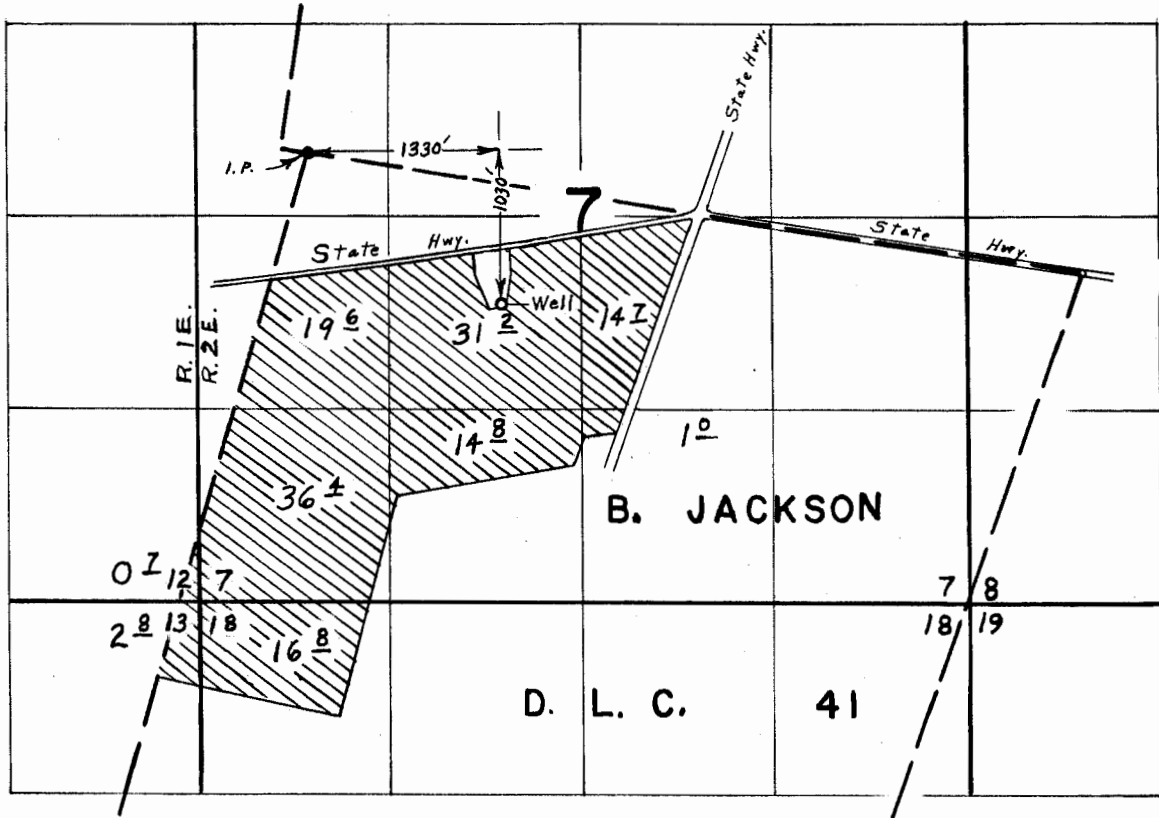

FINAL PROOF SURVEY UNDER

Application No. G-3129. Permit No. G-2958
IN NAME OF

GEORGE KYLLO

Surveyed Oct. 19, 1967, by L. E. Gould