


T. 26S. R. 6W. W.M.

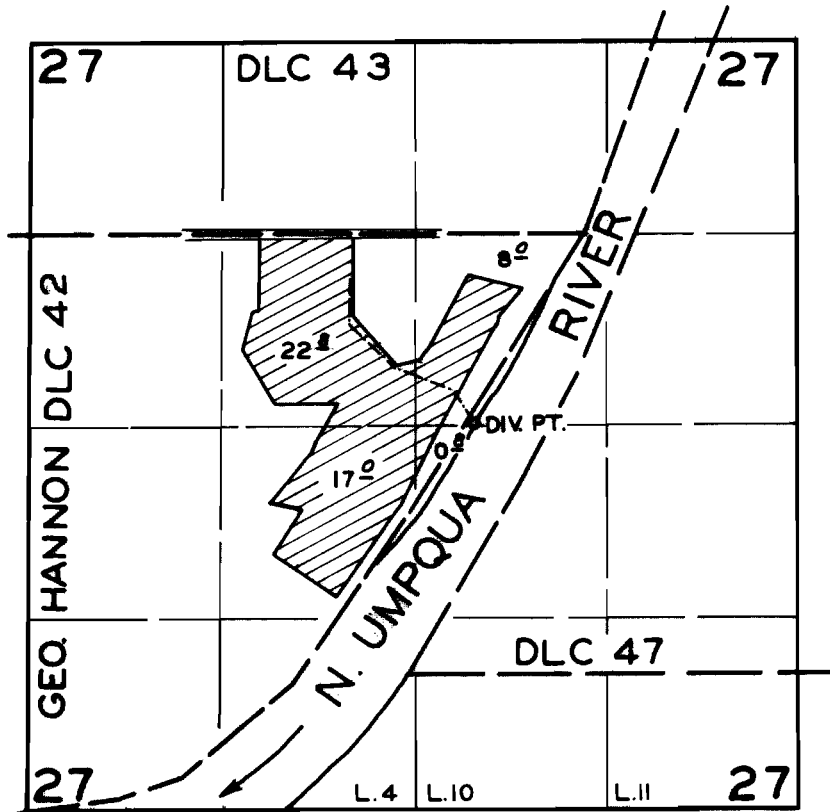

FINAL PROOF SURVEY
UNDER

Application No. 30552 Permit No. 24057
IN NAME OF

PETER J. PON

Surveyed AUG. 25, 1960, by C.O. BARTELS