


# T. 3 S. R. 1 E. W. M.

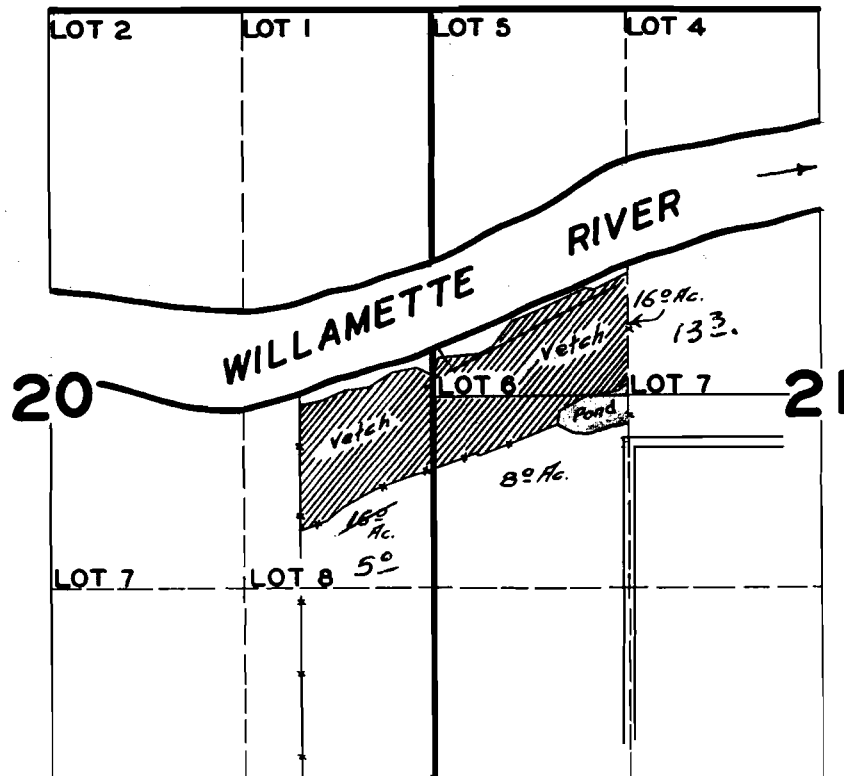

## FINAL PROOF SURVEY UNDER

Application No. 19598 Permit No. 15185

IN NAME OF

GEORGE B. WEBB & MARTHA R. WEBB

Surveyed, JUNE 14 1946, by

*Paul C. Russell*