


# T. 8S. R. 39E. W.M.

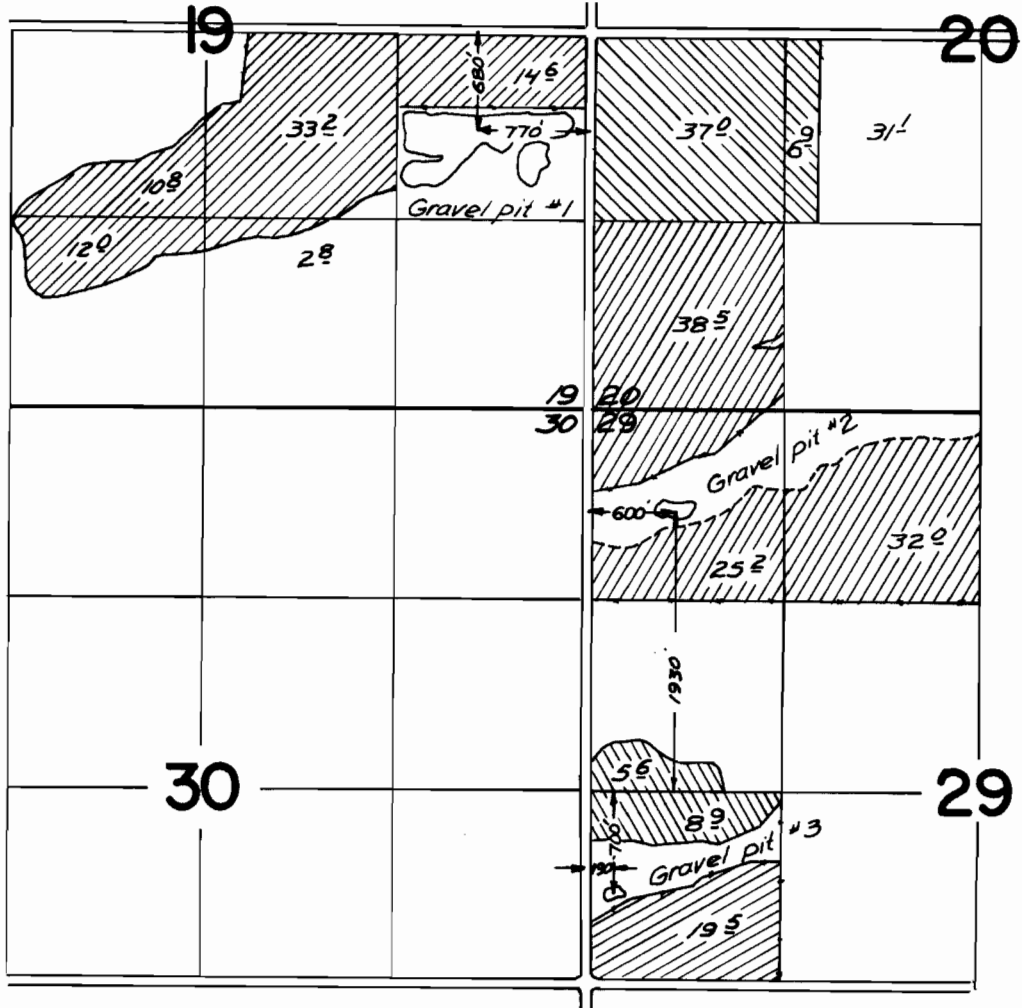

- |  |                           |  |                         |  |                         |  |                          |  |                        |
|--|---------------------------|--|-------------------------|--|-------------------------|--|--------------------------|--|------------------------|
|  | <i>Primary<br/>Pit #1</i> |  | <i>Suppl<br/>Pit #1</i> |  | <i>Suppl<br/>Pit #2</i> |  | <i>Primary<br/>Pit 3</i> |  | <i>Suppl<br/>Pit 3</i> |
|--|---------------------------|--|-------------------------|--|-------------------------|--|--------------------------|--|------------------------|

## FINAL PROOF SURVEY UNDER

Application No. G-3075 Permit No. G-2877  
IN NAME OF

NORMAN BUTLER

Surveyed Oct. 25, 26 19.67, by V. Garner