


T. 17 S. R. 1 W. W. M.

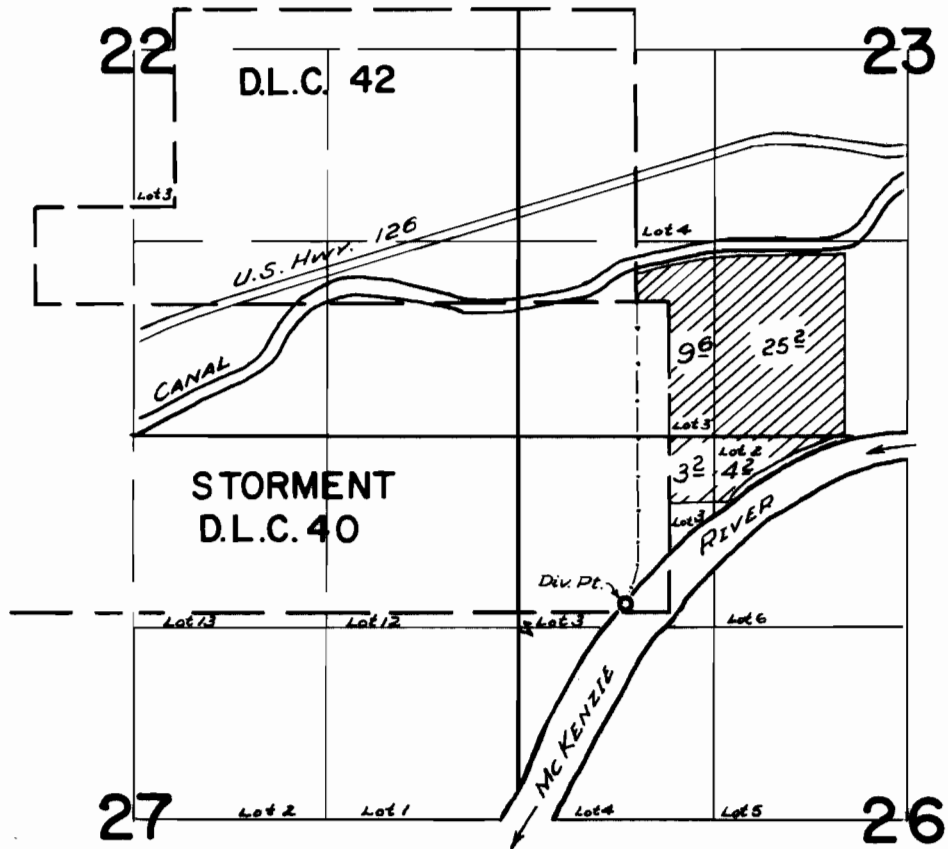

**FINAL PROOF SURVEY**  
UNDER

Application No. 23843 Permit No. 18782  
IN NAME OF

J. IRA McNUTT

Surveyed 29 AUG. 1960, by m. Bish