


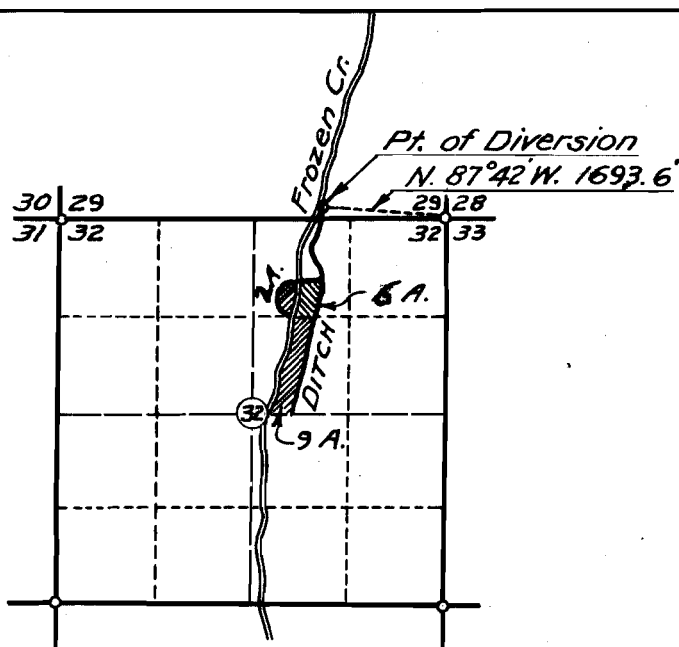

MAP OF
O. E. LEIGHTON,
 — IN —

SEC. 32 T. 28 S. R. 4 W. W. M.

Douglas Co., Oregon
 — Office of —
H. L. Eppstein, Co. Surveyor

CERTIFICATE OF SURVEYOR

I, H. L. Eppstein, of Roseburg, Ore., do hereby certify that this map was made from notes, taken during an actual Survey under my immediate supervision, and that it correctly represents the work described in the accompanying application, together with the location of streams and other ditches in the immediate vicinity.

H. L. Eppstein
 Registered Professional Engineer.

License No. 1011.

November 8, 1920