


T.28S. R.4W. W.M.

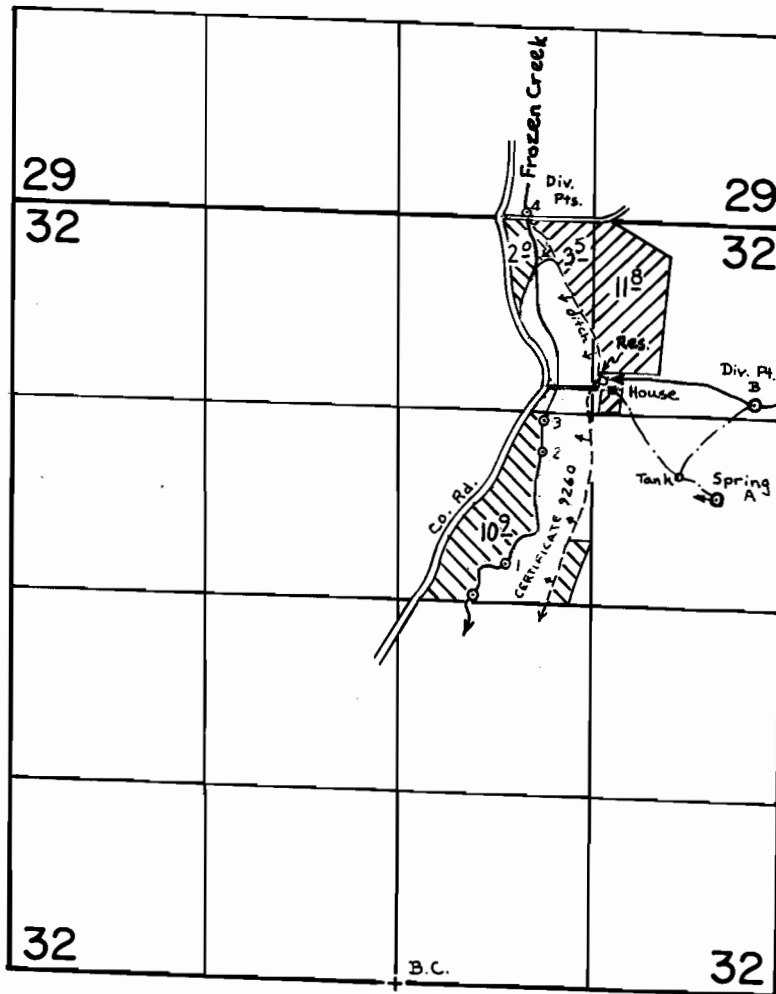

Spring & Div. Pts. Located:

- A 1980' S & 450' W
- B 1230' S & 200' W
- 4 30' N & 1770' W

- 3 1400' S & 1640' W
- 2 1600' S & 1650' W
- 1 2400' S & 1900' W

Res. 1100' S & 1250' W

all from the NE corner of Section 32

SCALE: 4" = 1 mile

FINAL PROOF SURVEY UNDER

R-55405

R-6616

Application No. 55406 Permit No. 41808
IN NAME OF

DUANE SMITH

Surveyed March 2, 1979, by S. Donaldson...