


RECEIVED

JUN 18 1979

WATER RESOURCES DEPT.  
SALEM, OREGON

T.1S.R4W.W.M.

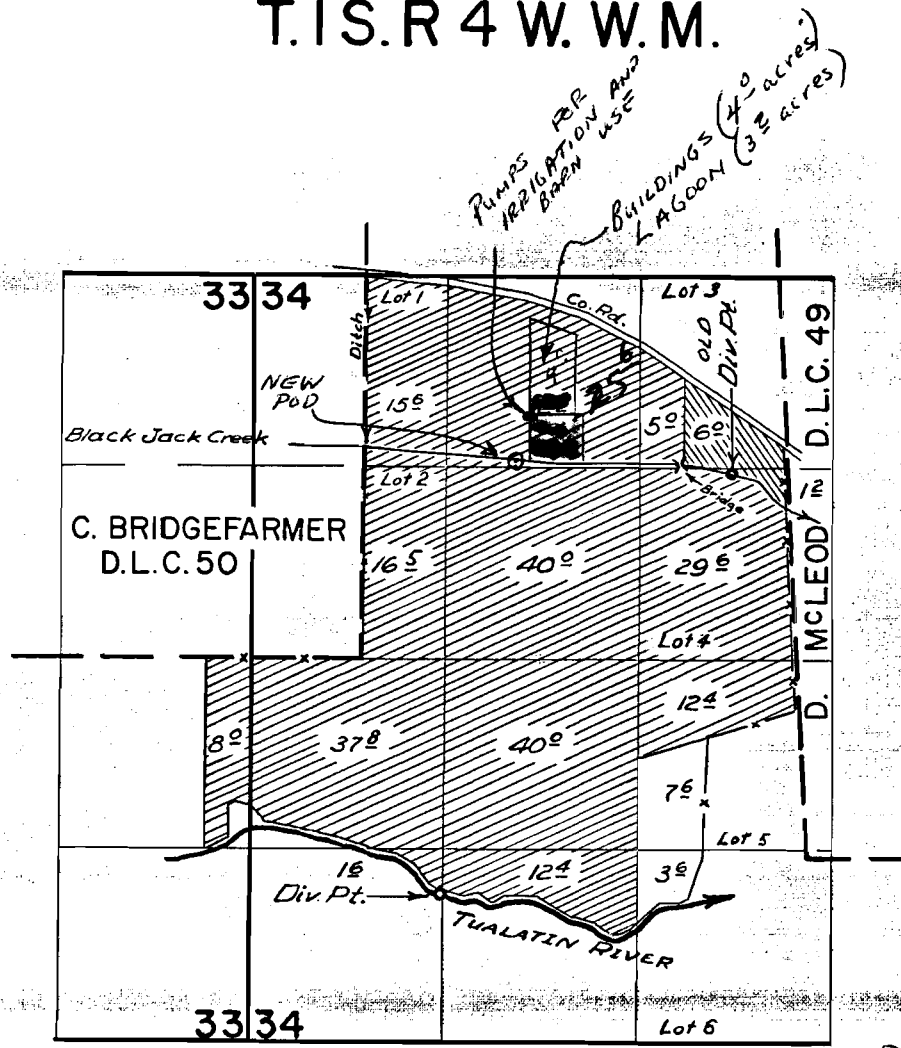

NEW P.O.D. BLACK JACK CR: 1360 FT N AND 1050 FT E } Both from SE  
 P.O.D. ON LAGOON : 1680 FT N AND 1150 FT E } Cor DLC 50

~~FINAL PROOF SURVEY~~  
 UNDER

Application No. ~~34142~~ 58800  
 Permit No. R 7935  
 44405

Application No. ~~34142~~ Permit No. ~~26902~~  
 IN NAME OF

ODERS BROS.

Surveyed Mar 25 1963, by W. B. Sch