


T. 12S., R. 26E., W.M.

P24073

T5368

75794

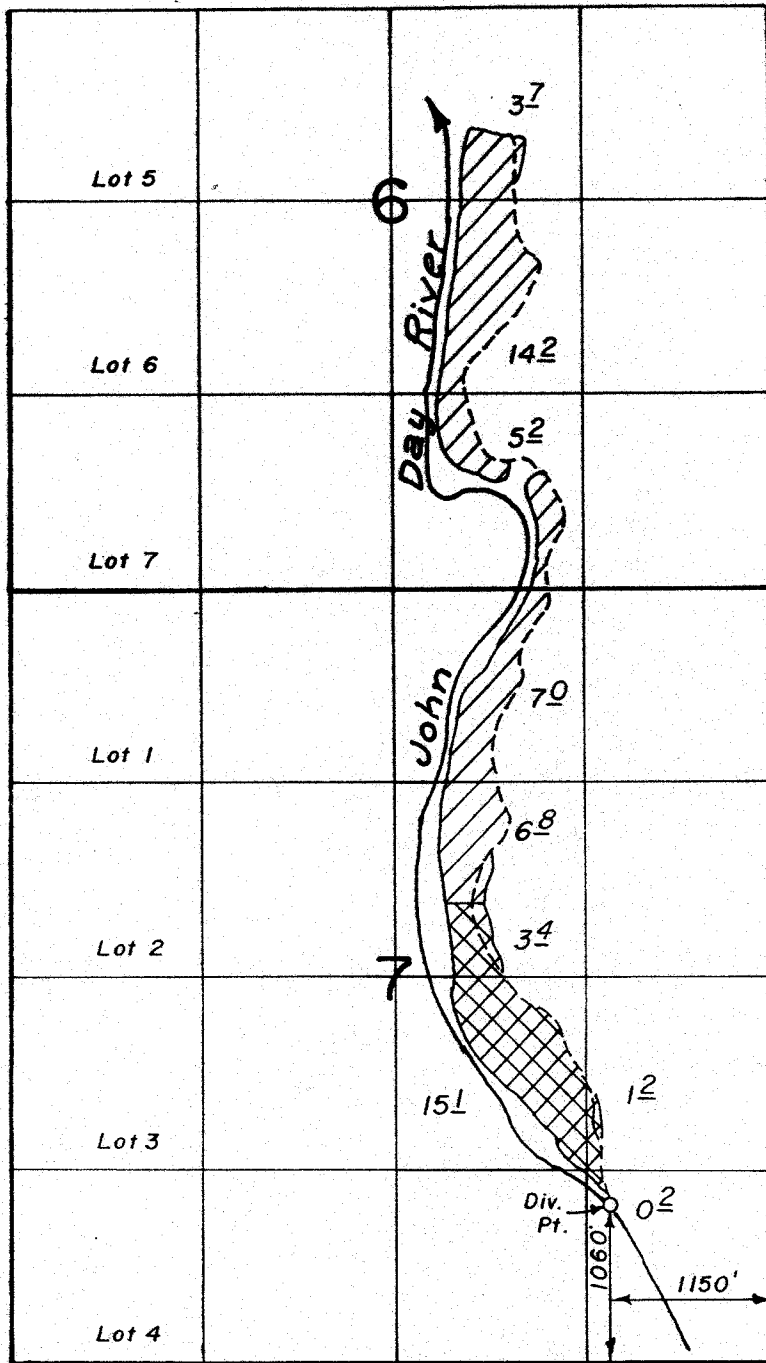

**FINAL PROOF SURVEY
UNDER**

Transfer No.'s 5367 & 5368
Application No. 66014 Permit No. 49554
IN NAME OF

John Day Fossil Beds

Surveyed June 16, 1988, by T. Warren

41023-179-23L *gfb*