

T. 29 S. R. 4 W. W.M.


T-4805

BC (N $\frac{1}{4}$ Cor.)


Lot 1

5 4

RECEIVED
JUN 30 1981
WATER RESOURCES DEPT
SALEM, OREGON

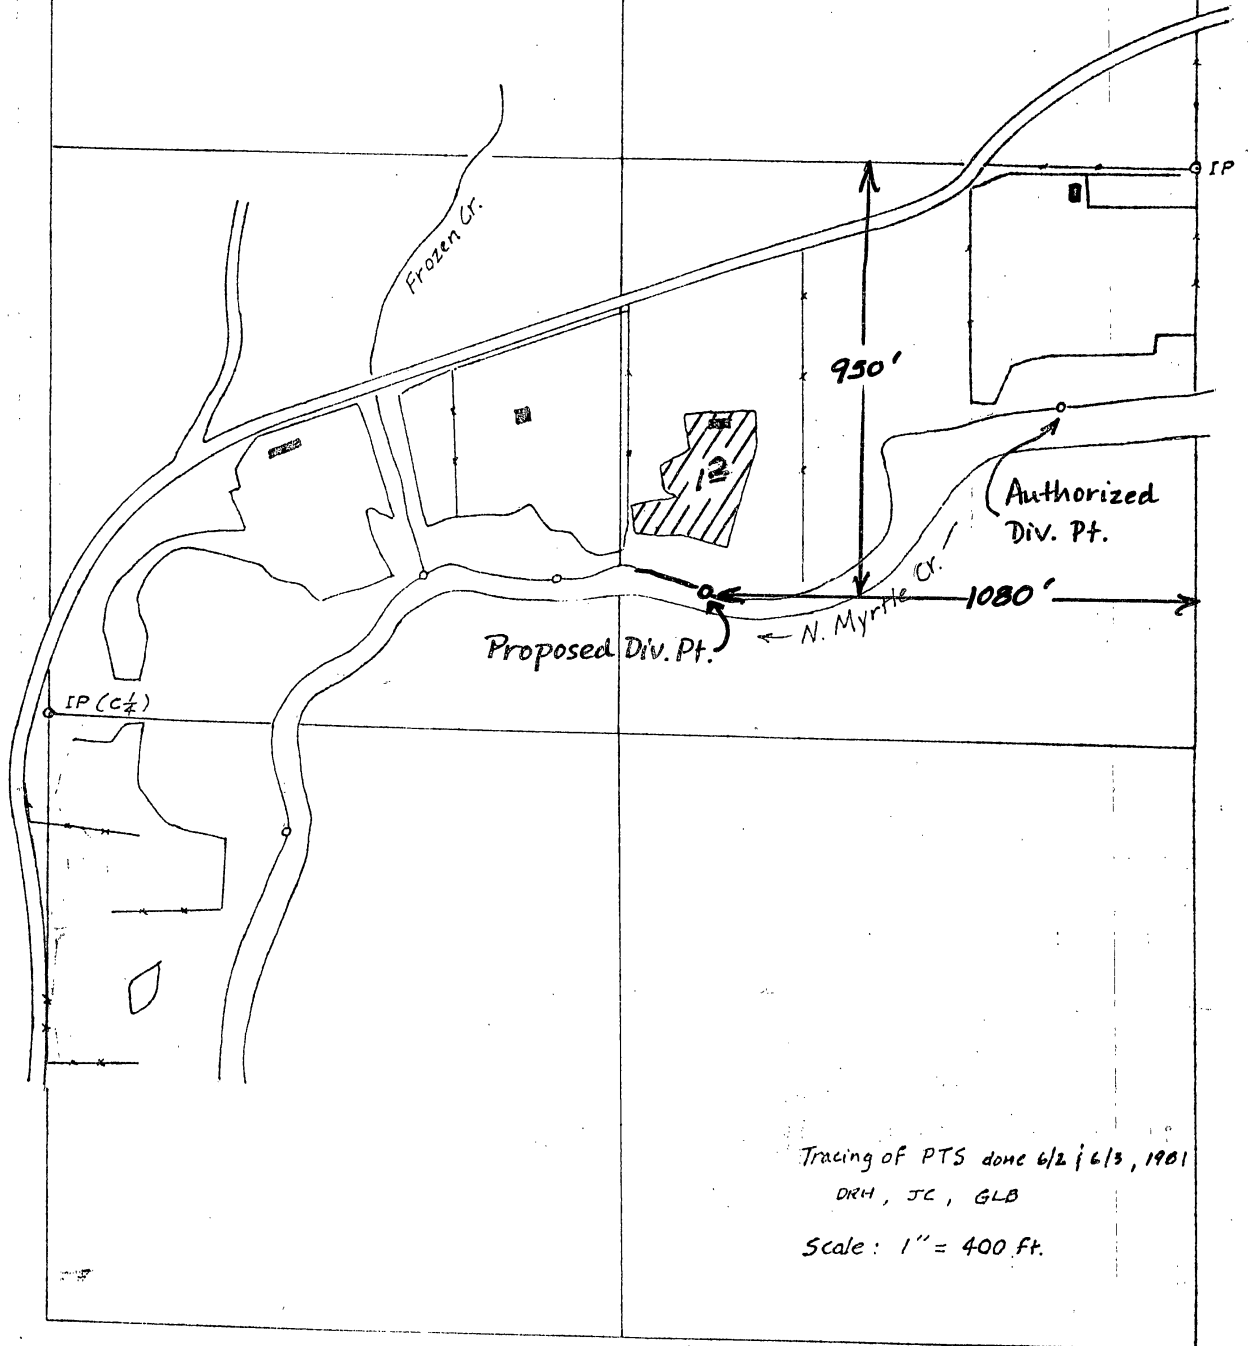

T.29S., R.4 W., W.M. SECTION 5

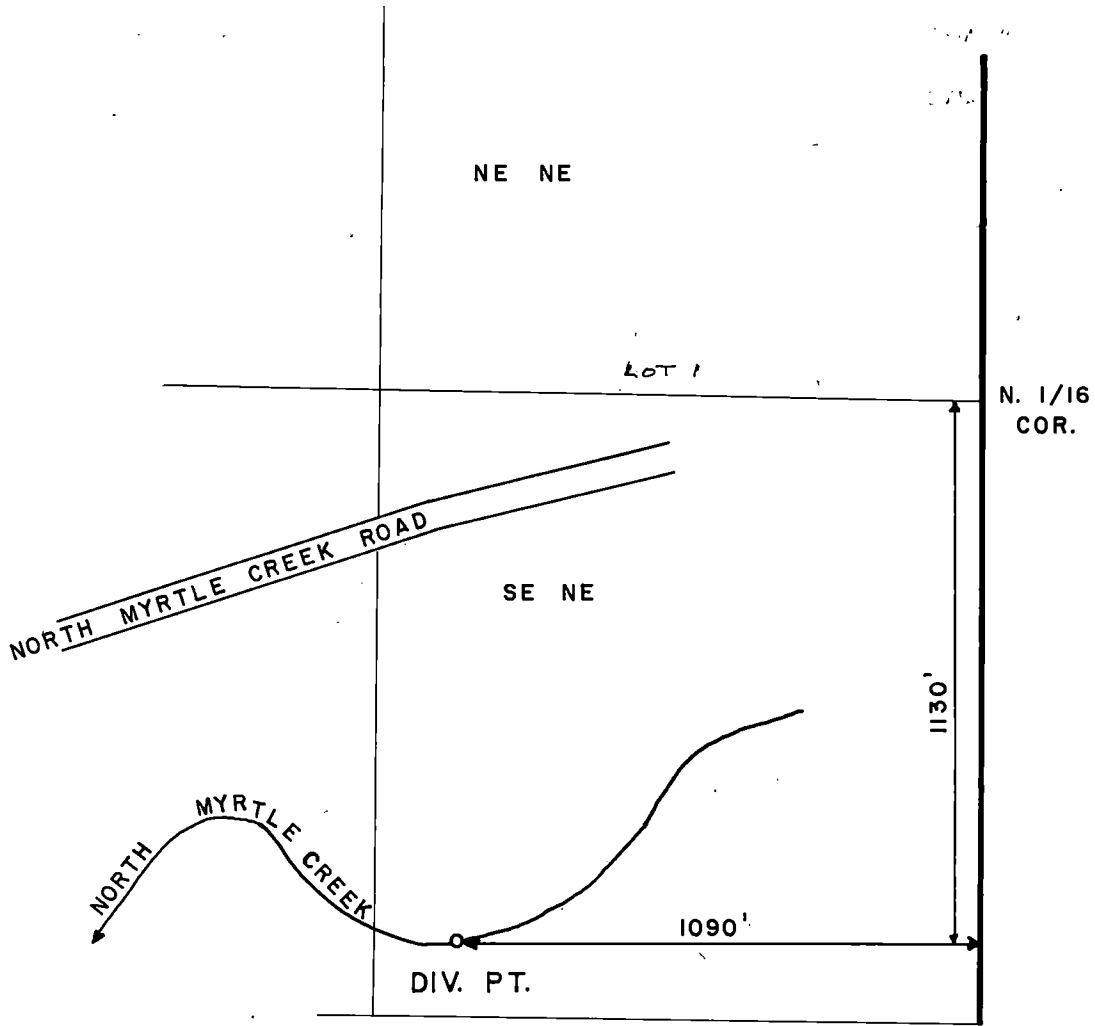

SCALE : 1" = 400'

FINAL PROOF SURVEY UNDER

TRANSFER NO. 4805
IN NAME OF

GARY L. & ROMA B. JACKSON

Surveyed MAY 15, 1986, by J. M. SCHMORDE