


T.26S. R.6W. W.M.

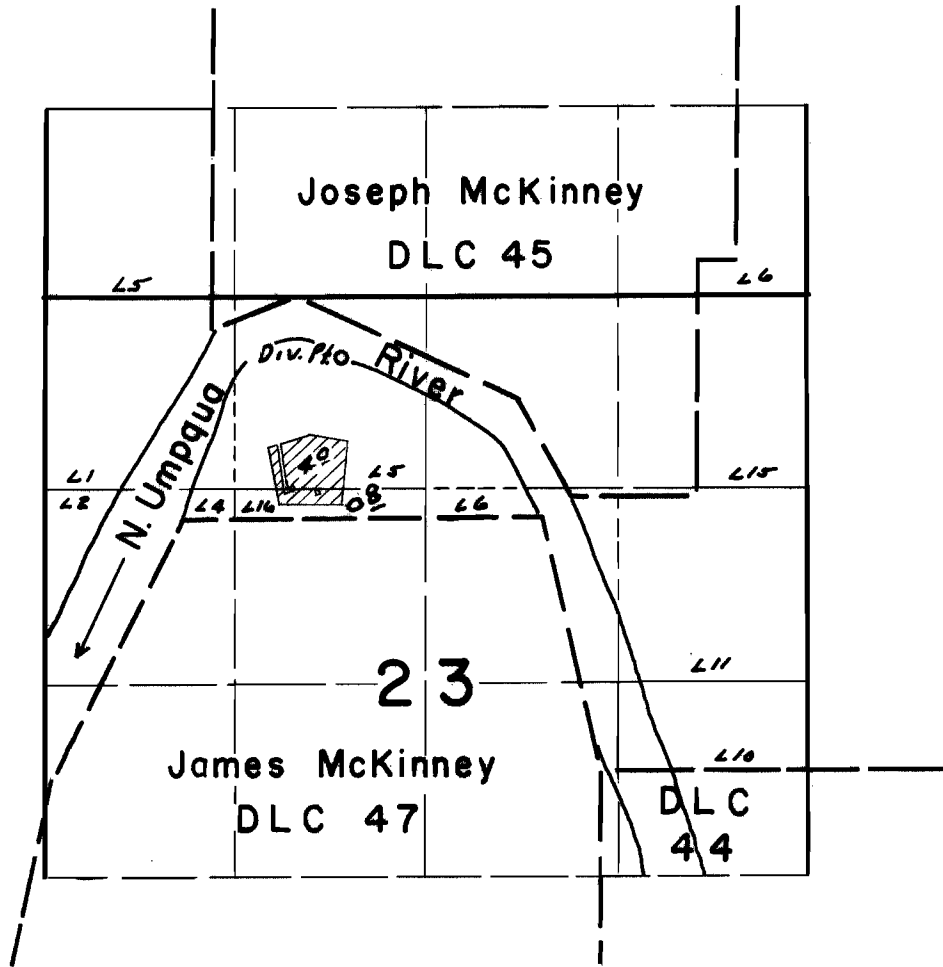

FINAL PROOF SURVEY
UNDER

Application No. 38479 Permit No. 28711
IN NAME OF
G. F. REYNOLDS

Surveyed July 14, 1964, by *A. J. Gardner*