


JOHN DAY RIVER

54 2000 04 53 172
From John Day R. 01

32
P 24769

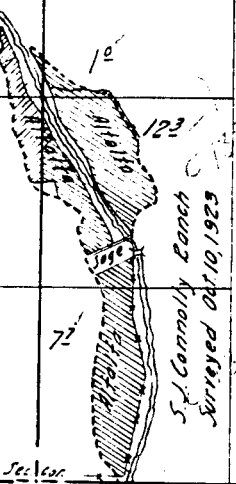

10
123
72
S. J. Connolly Ranch
Surveyed Oct 10, 1923
Section

2


1

Connolly ditch #2

11

12

BRIDGE CREEK

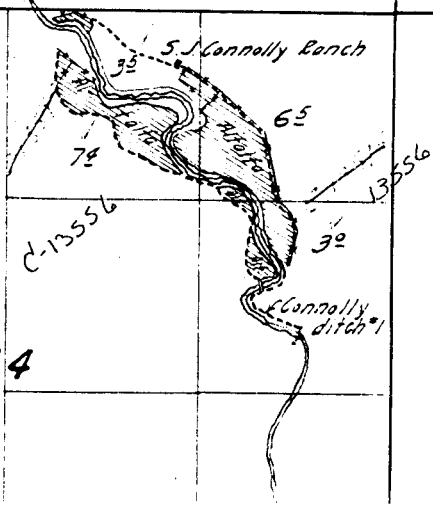

5. J. Connolly Ranch
78
33
65
32
Connolly ditch #1
13556

14


13

Township

10 S,

Range

20 E.

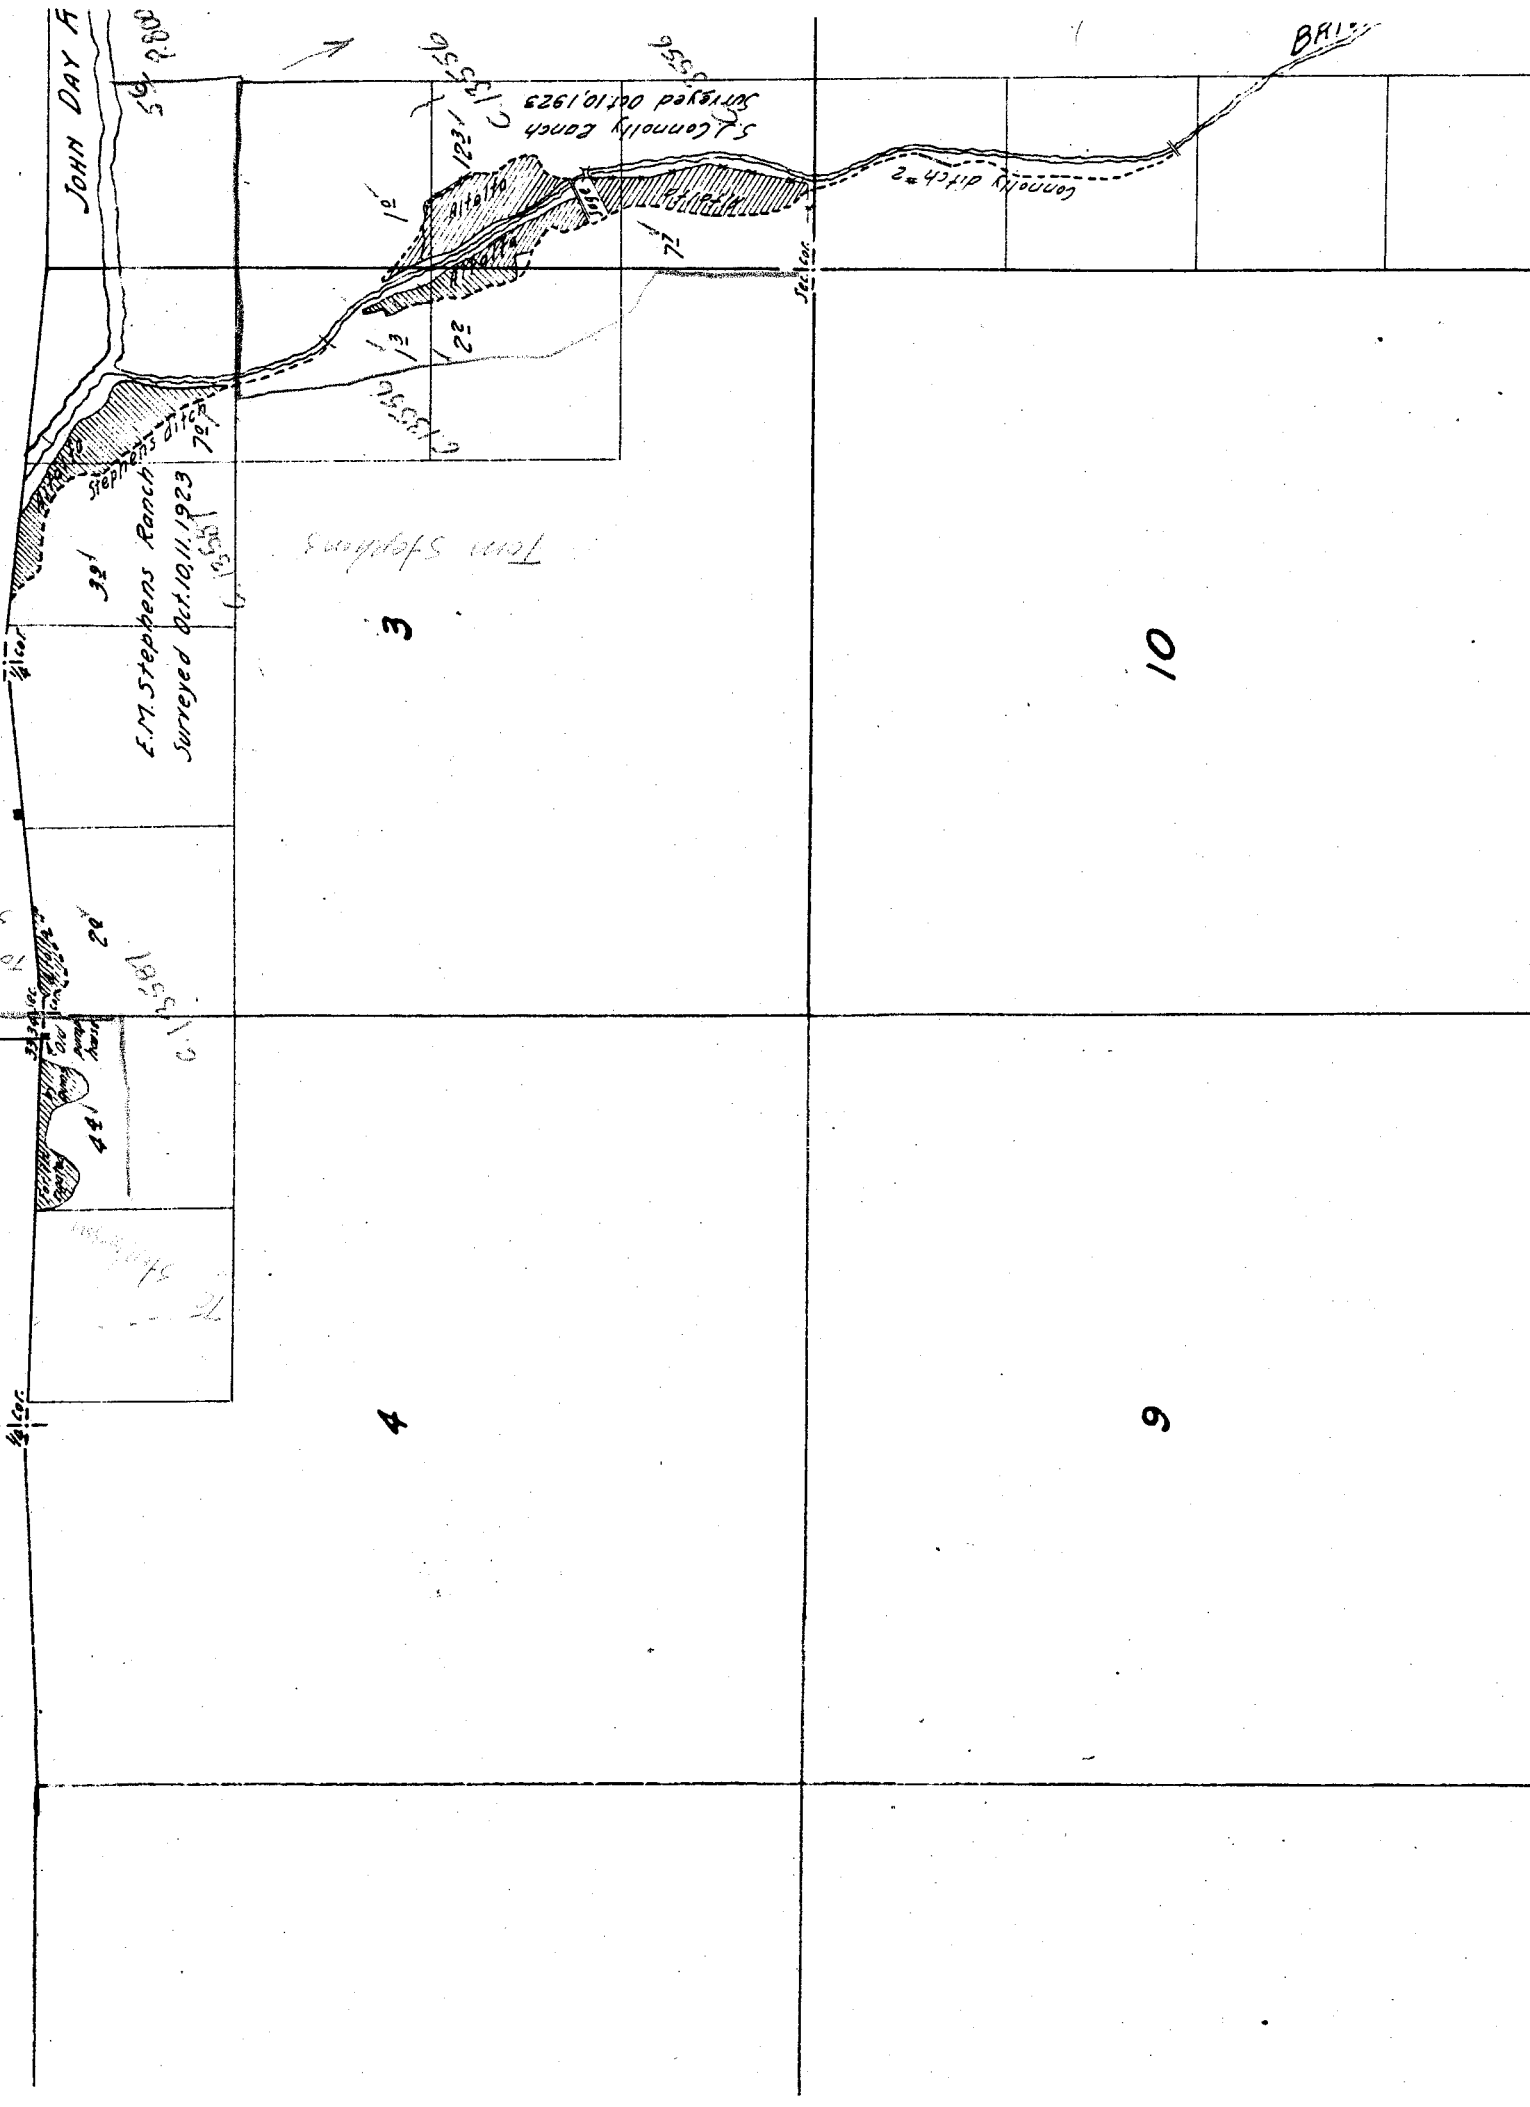

	15	22	
	16	12	

6

5

7

8

18

17

7

8

18

17

19

20

30

29

28

31

32.

33

18

17

16

19

20


21

28

27

33

34

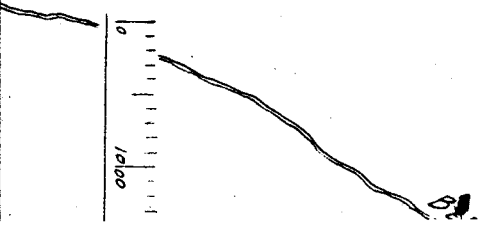


27

34

26

35

36

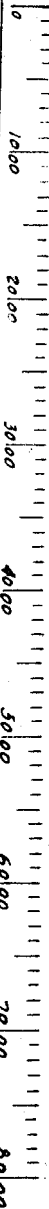

BEAR CREEK

x P. 617B

P. 617B

20 10

Ed. No. 10A



Witness tree - O
C. 13593

Ben Taylor Ranch
Surveyed Oct. 58, 1923

15


14

13

22

23

24

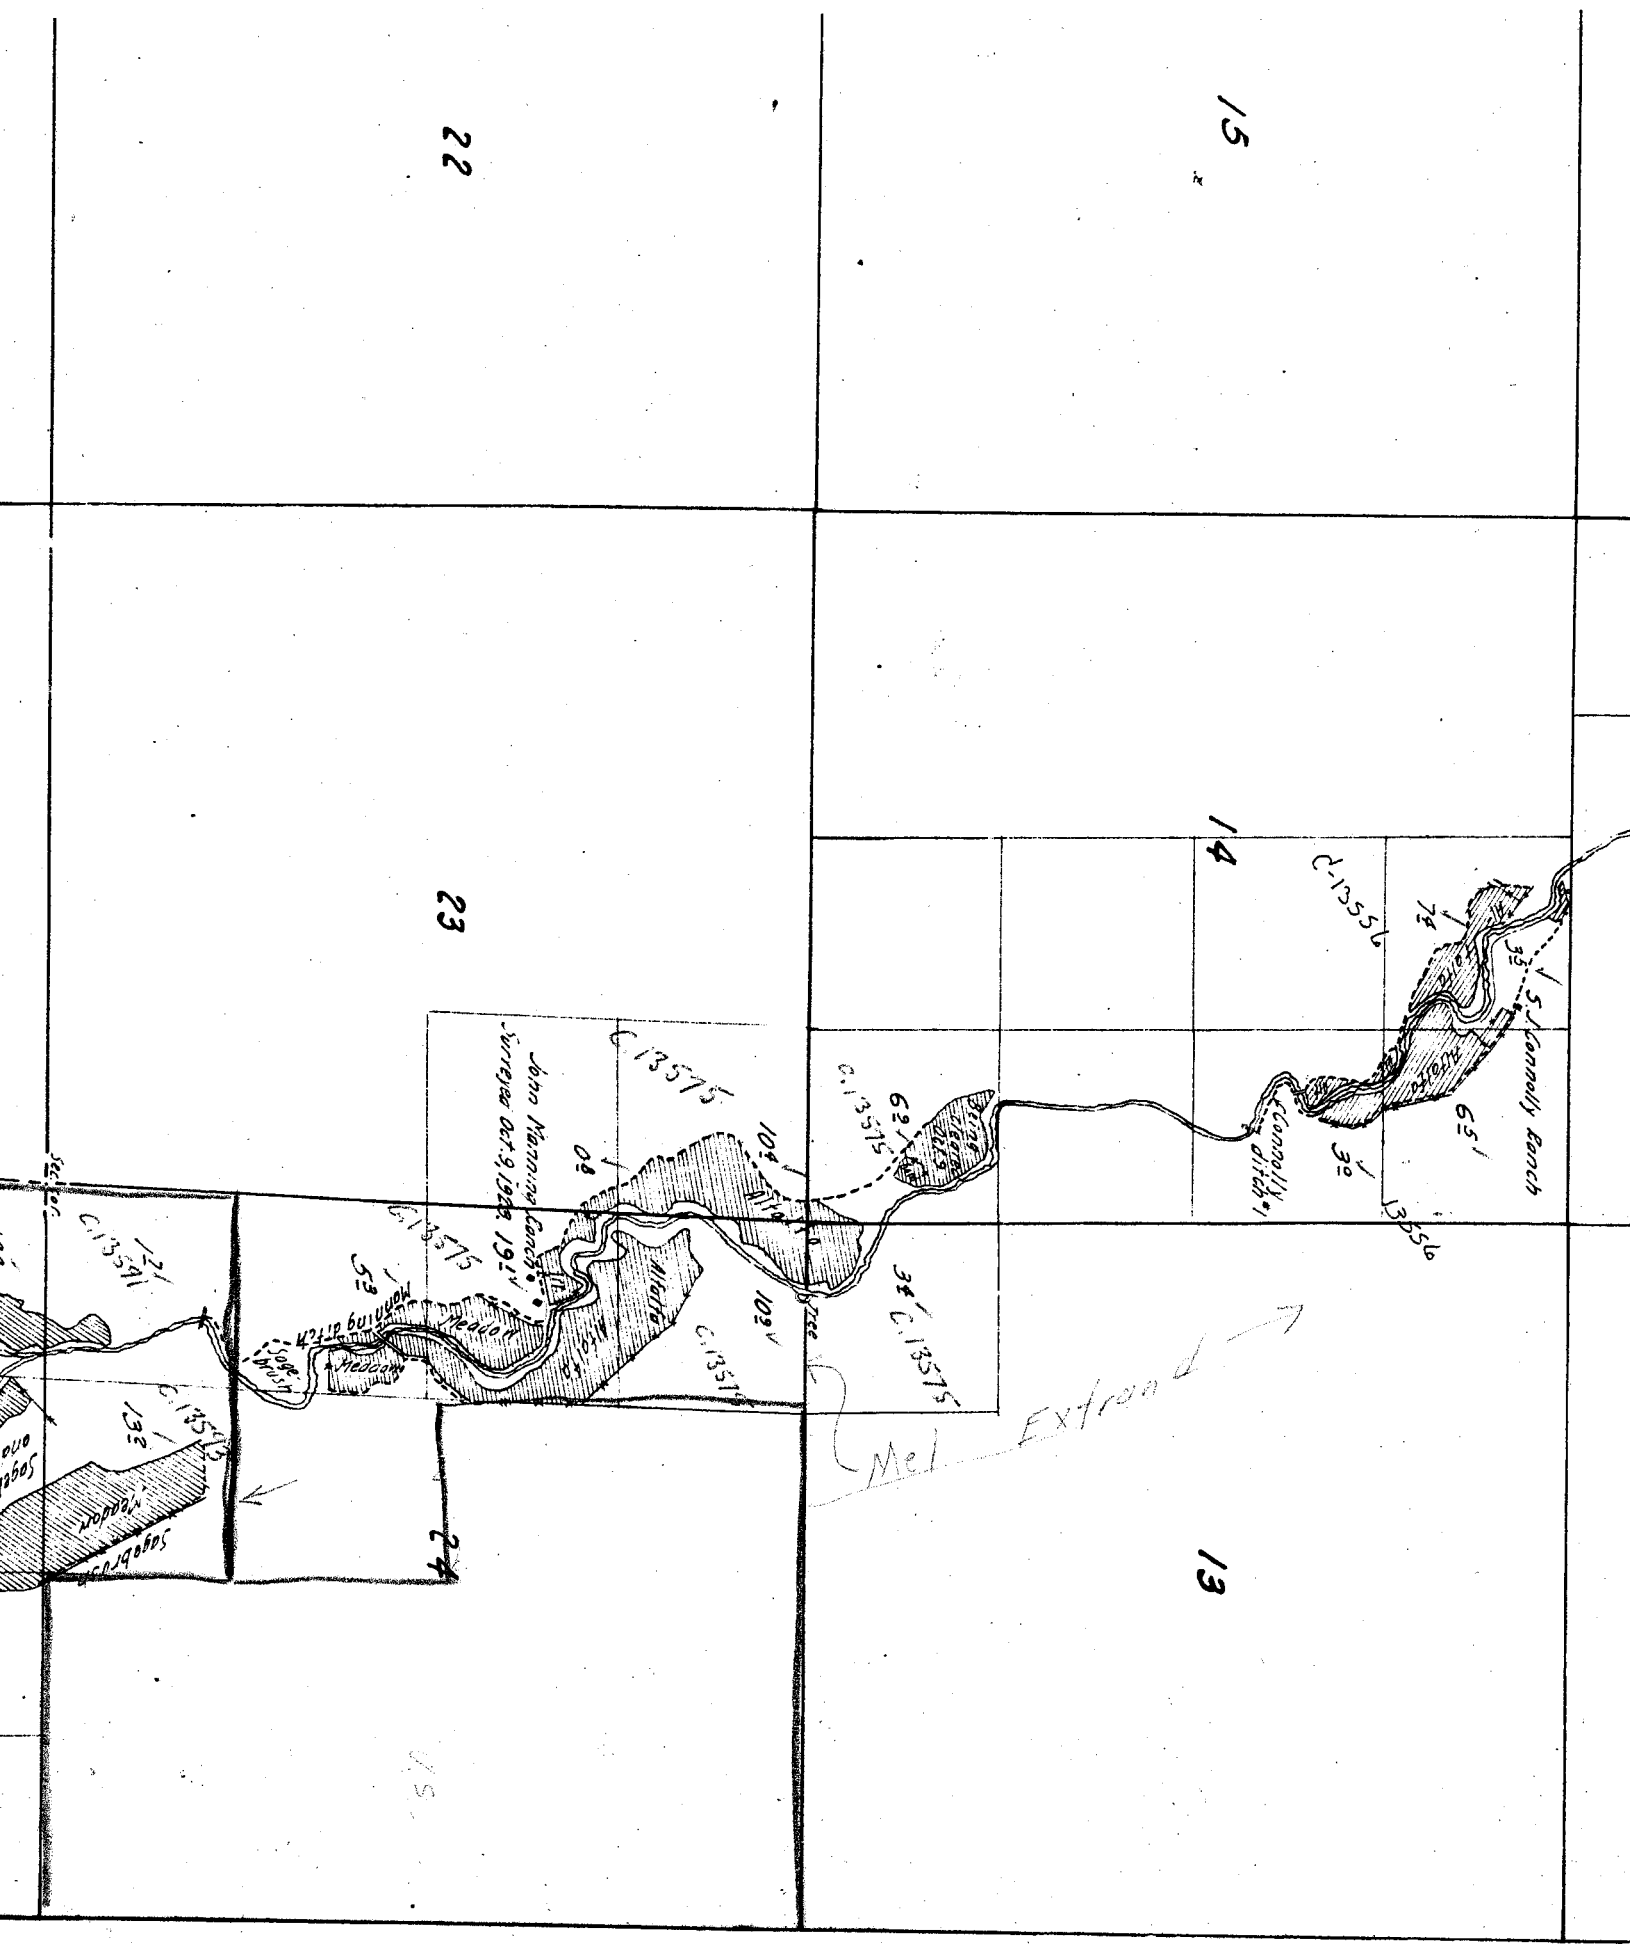

16

15

21

22