


T4S.,R16E,WM.

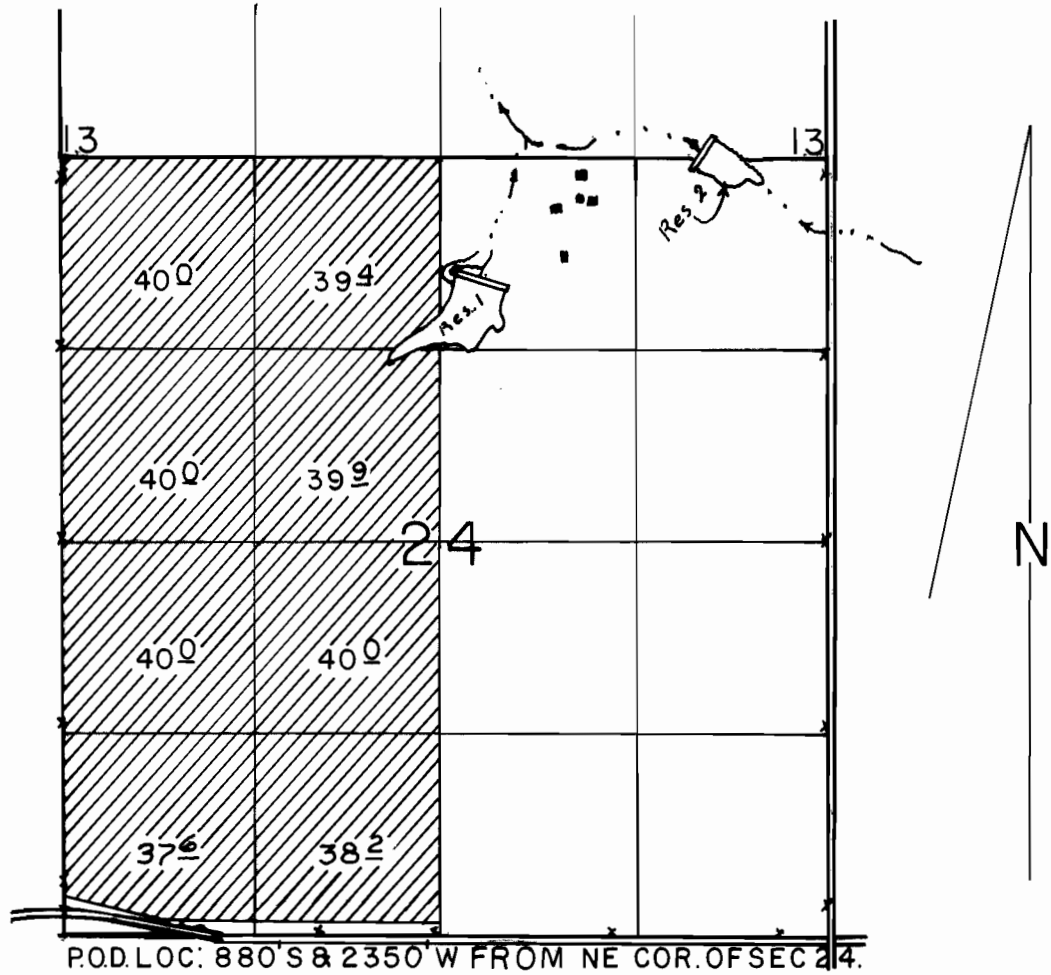

SCALE: 1"=1320'

FINAL PROOF SURVEY UNDER

Application No. 64886 Permit No. 47371
R-64885 R-8600

IN NAME OF

CARL VONBORSTEL

Surveyed AUG 15 1995, by R.M. SUTTERFIELD