


T.29S.R.4W.W.M.

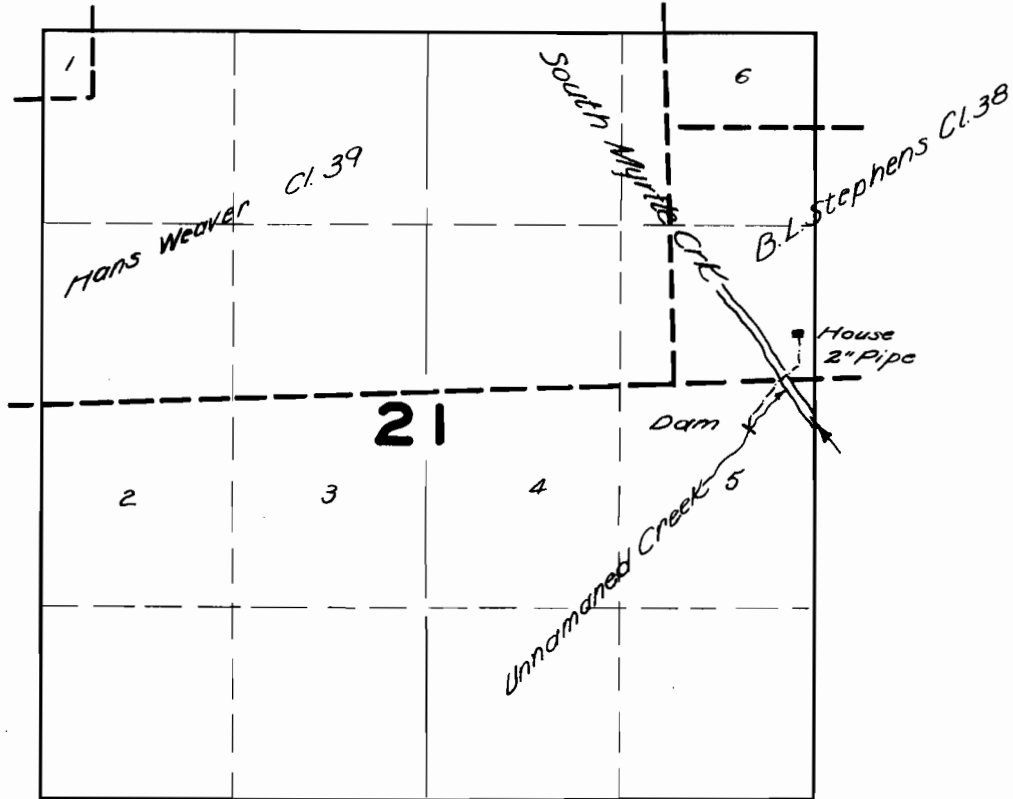

FINAL PROOF SURVEY

UNDER

Application No. **23793** Permit No. **18769**

IN NAME OF

HENRY W. BIGGS

Surveyed **MAY 25 1950**, by **HL. COFFMAN**