


P. 6655

N.

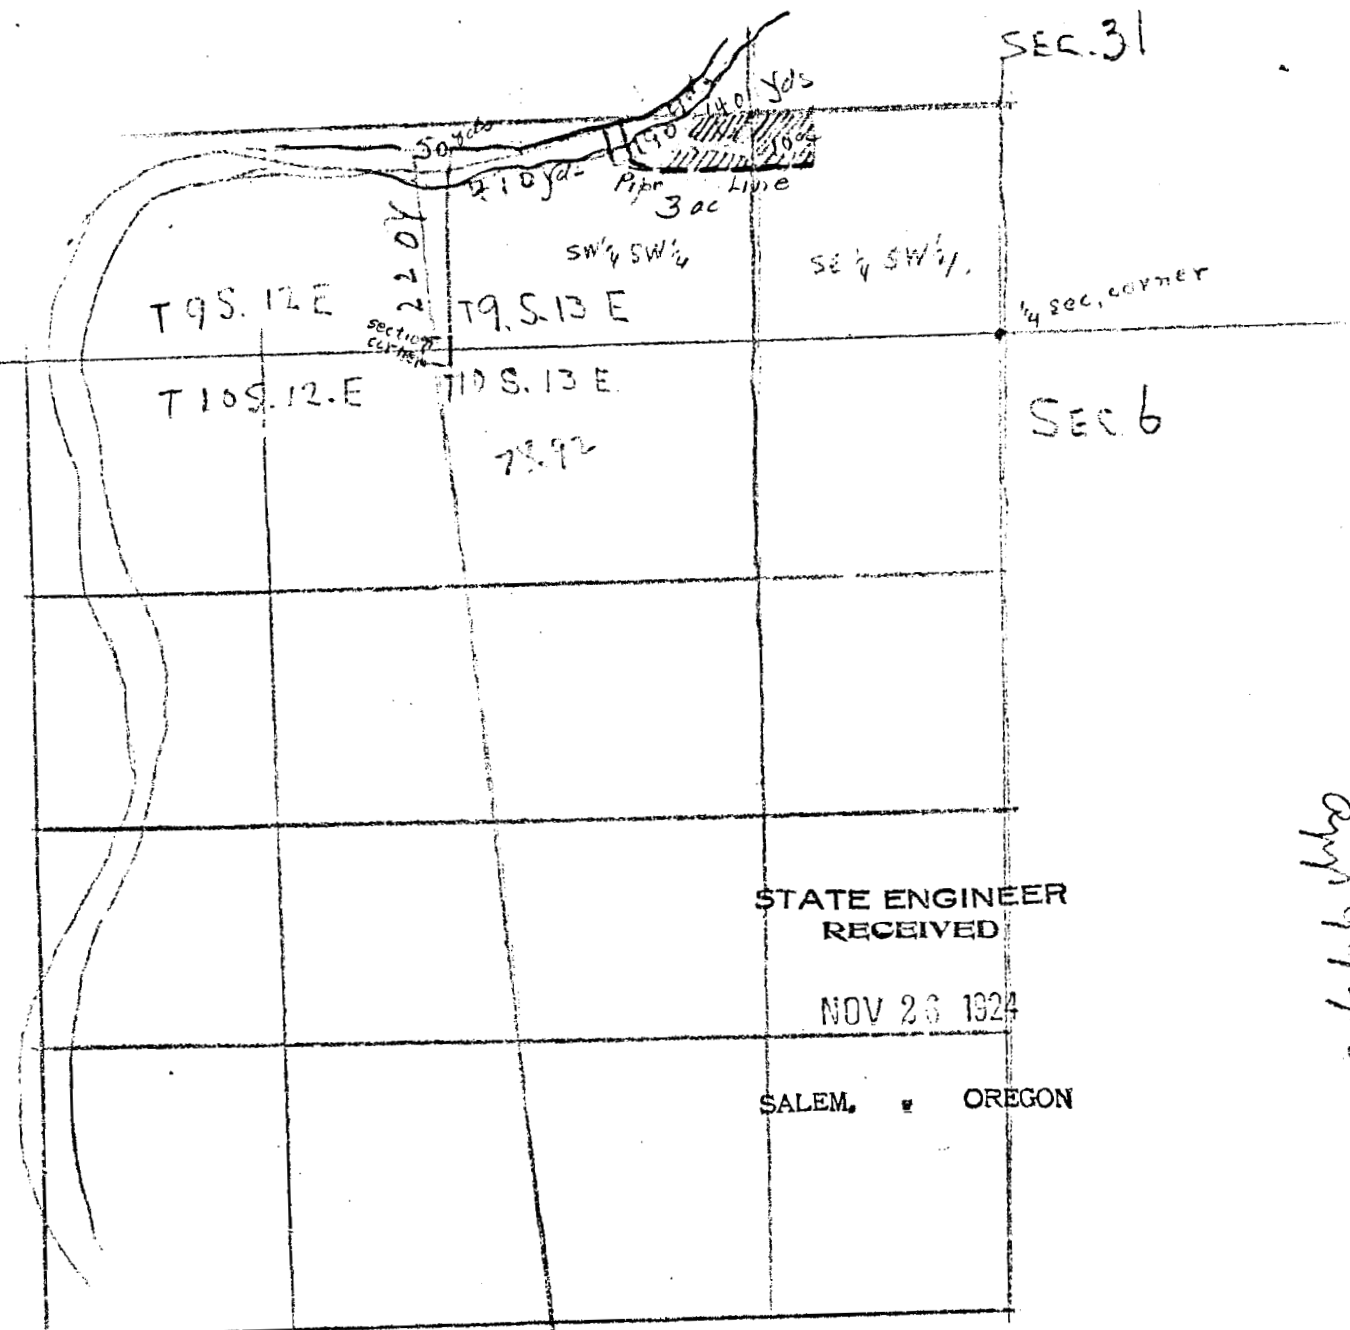

STATE ENGINEER
RECEIVED
NOV 26 1924
SALEM, OREGON

copy 99112

copy 7742

Application No. 6655
Permit No. 6655

C-7582

P# 6655