


G 8984  
52876  
T80B  
75825  
T80B

# T. 27S., R. 17E., W.M.

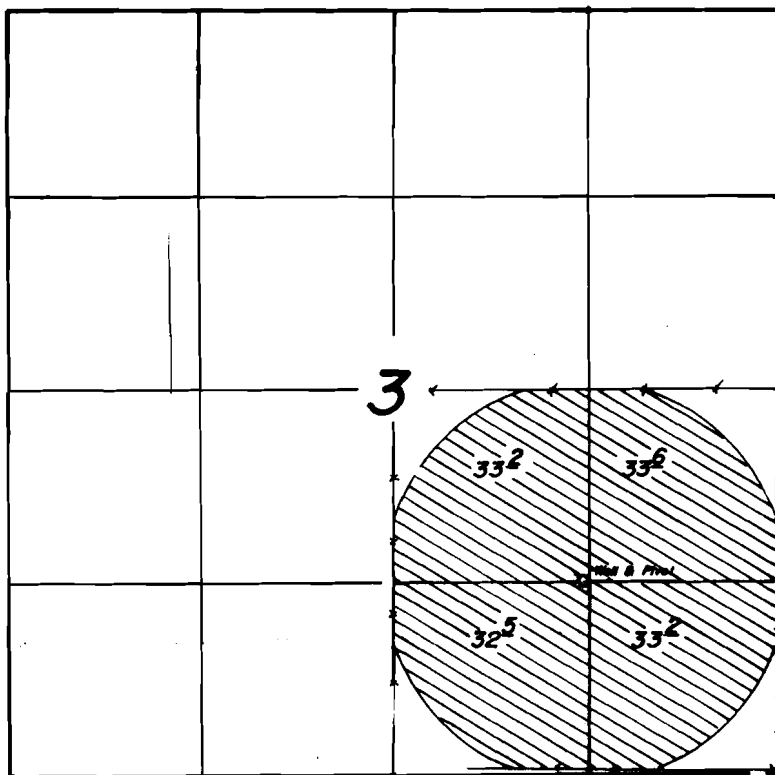

Well Loc.: 1320' N. & 1340' W. from the SE Cor. Section 3

## FINAL PROOF SURVEY UNDER

Application No. ~~G-9641~~ Permit No. ~~G-8984~~....  
IN NAME OF

**GYLAN MULKEY**

Surveyed OCT. 15, 1983, by L. TOLL.....