T.38S.,R.3W.,W.M.

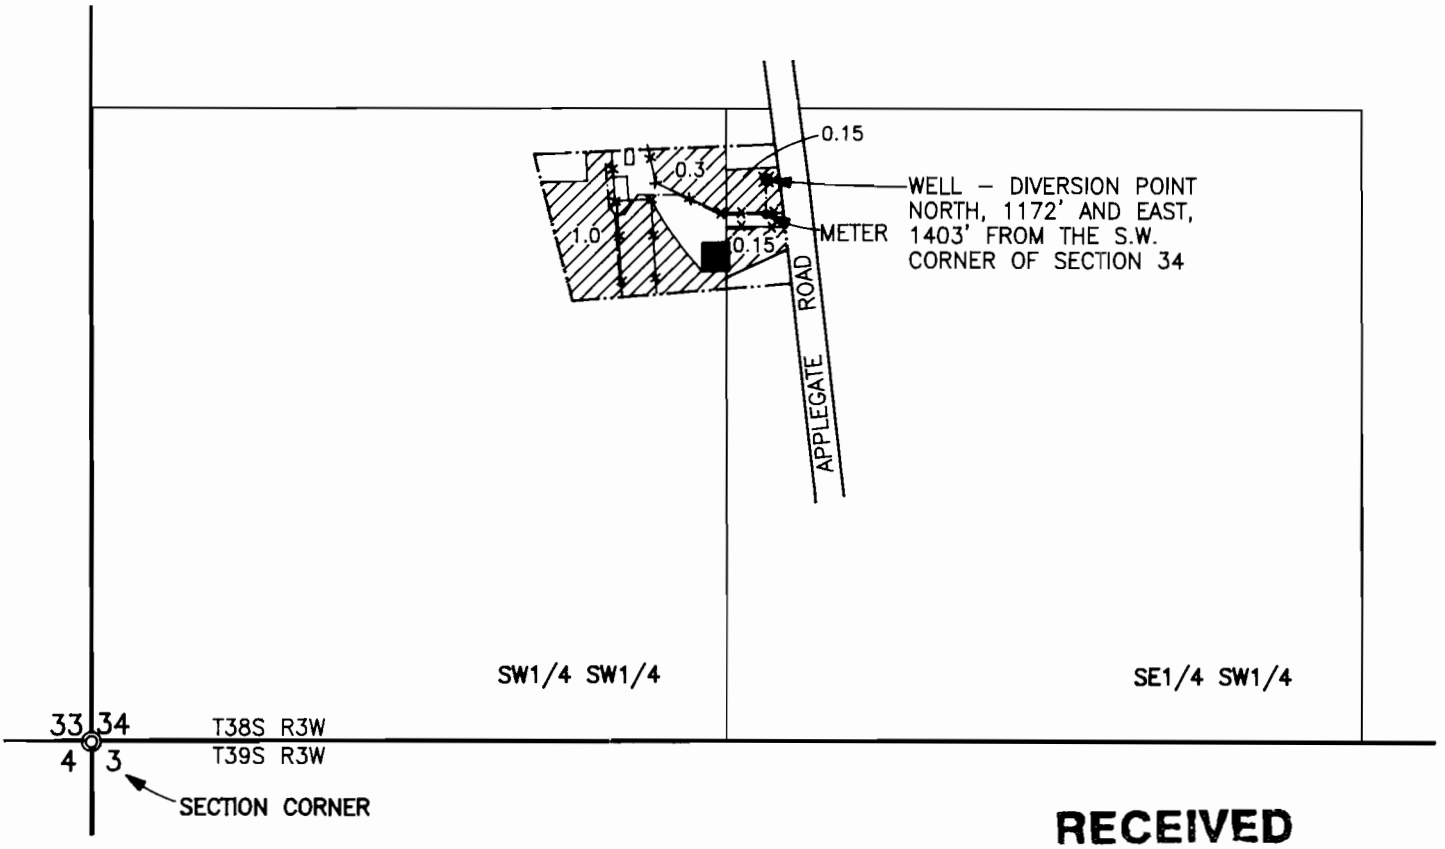

RECEIVED

SEP 1 1 2000

WATER RESOURCES DEPT.
SALEM, OREGON

FINAL PROOF MAP

APPLICATION No. T-7908

NOTE: MAP PREPARED FOR WATER RIGHT PURPOSES ONLY, NOT FOR PROPERTY BOUNDARY LOCATIONS.

IN THE NAME OF
CATHERINE GOYENECHE
1518 UPPER APPLEGATE ROAD
JACKSONVILLE, OR. 97530

y.o.k

MAP PREPARED AUGUST 23, 2000 BY GARY D. KAISER

T. 38 S., R. 3 W., W.M.

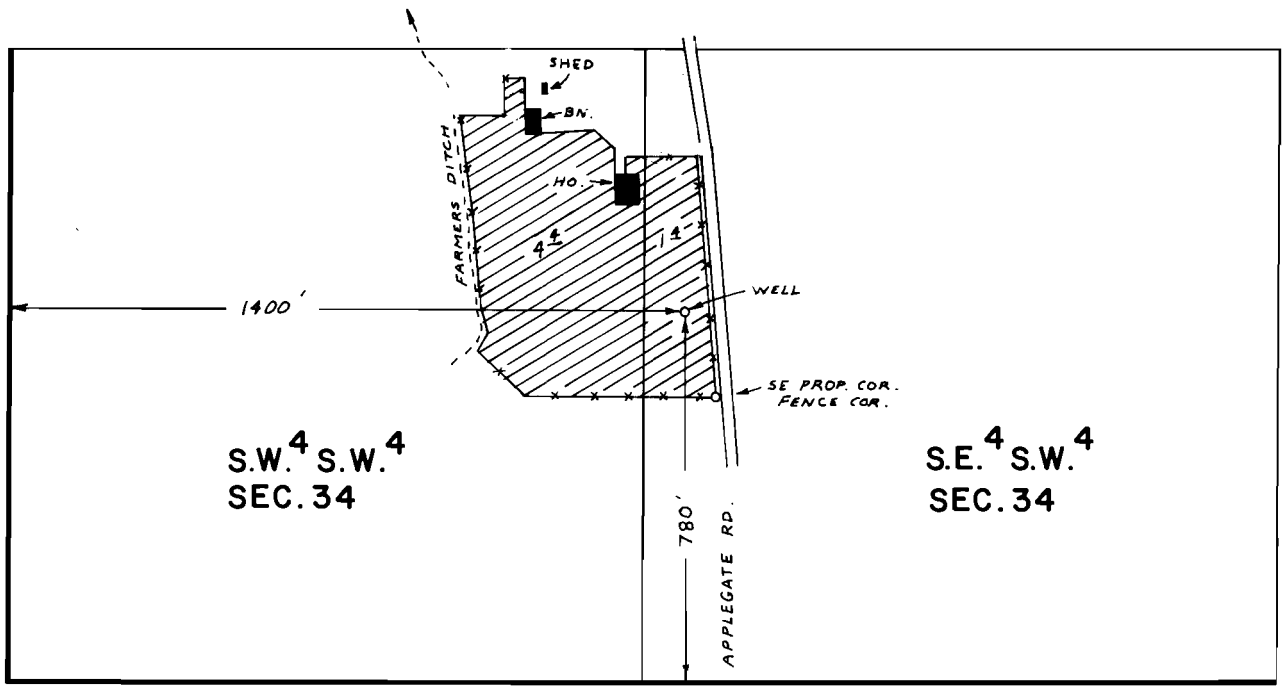

SCALE: 1" = 400 FT.

FINAL PROOF SURVEY
UNDER

Application No. G-8384 Permit No. G-7851

IN NAME OF

BRENICK &/OR RUTHE O'DAY

Surveyed MAY 11 19 79, by B. SUND

P.T.S.- 1979 - 14 - A