


T. 38 S., R. 3 W., W.M.

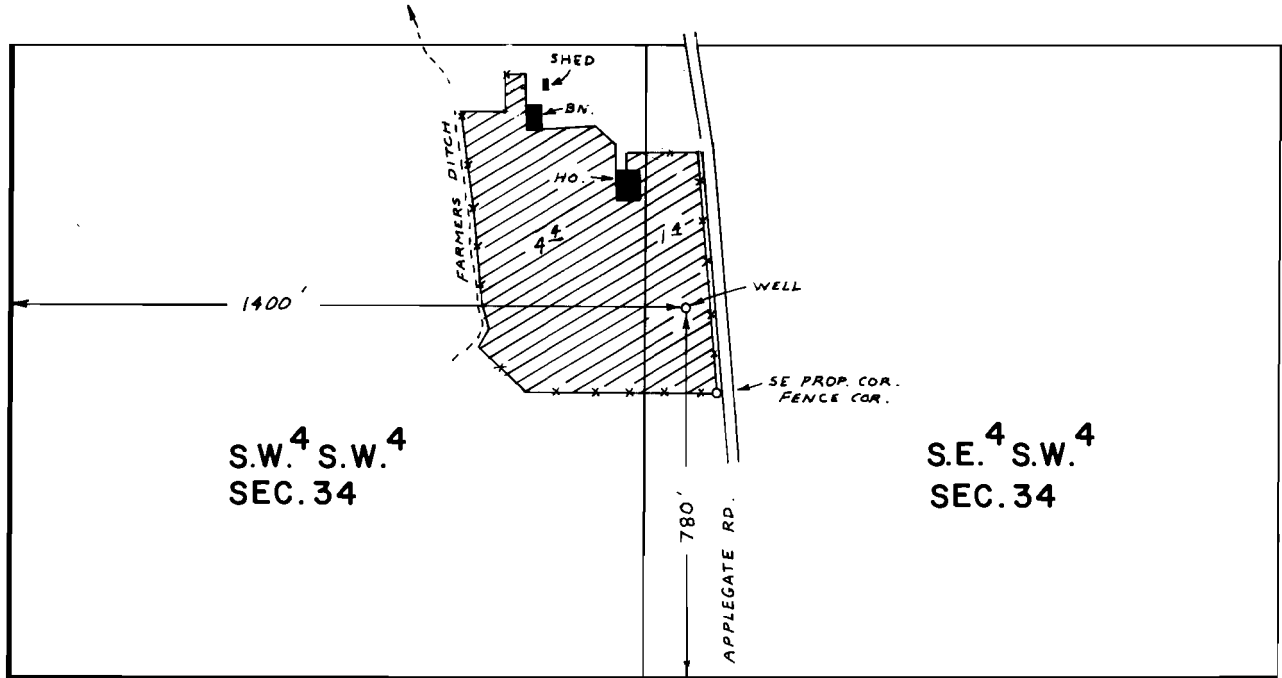

SCALE: 1" = 400 FT.

FINAL PROOF SURVEY
UNDER

Application No. G-8384 Permit No. G-7851
IN NAME OF

BRENICK &/OR RUTHE O'DAY

Surveyed MAY 11 1979 by B. SUND