


G-7191
64430
75828
T8028

T.27S.,R.17&18E.,W.M.

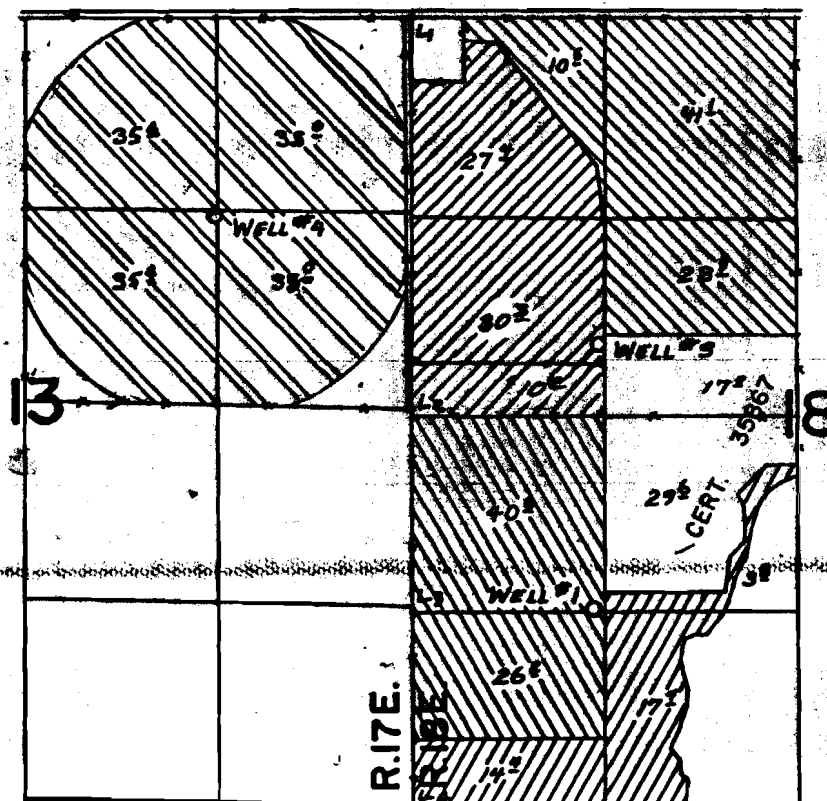


WELL #1 - 4040 ft. S and 1240 ft E
WELL #3 - 2240 ft. S and 1290 ft E
WELL #4 - 1350 ft. S and 1350 ft. W } all from the NW Cor.
Sec. 18

FINAL PROOF SURVEY

G-7737

G-7191

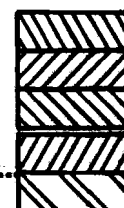

WELL 1- PRIMARY
WELL 3- PRIMARY
WELL 3-SUPPLEMENTAL
WELL 1- PRIMARY
WELL 4- PRIMARY

Application No. G-9385 Permit No. G-9311
IN NAME OF

JACK L. GILLETTE

Surveyed OCT. 28. 19.81., by L.TOLL