


G-9311
64434
75829
T8028

T.27S.,R.17&18E.,W.M.

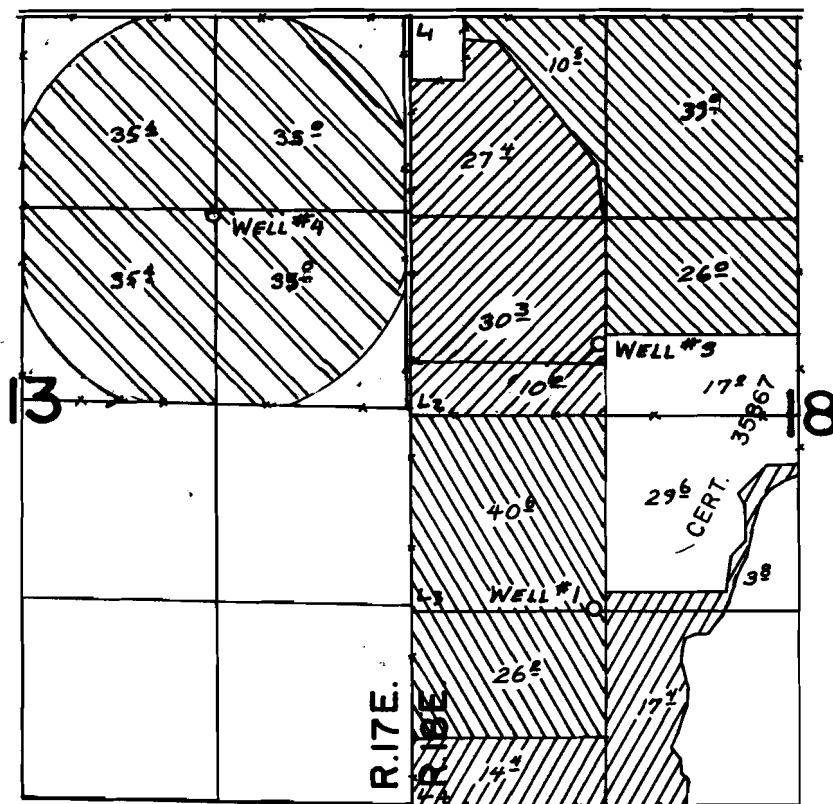

WELL #1 - 4040 ft. S and 1240 ft. E } all from the NW Cor.
WELL #3 - 2240 ft. S and 1290 ft. E } Sec. 18
WELL #4 - 1350 ft. S and 1350 ft. W }

FINAL PROOF SURVEY

G-7737

G-7191

	WELL 1- PRIMARY
	WELL 3- PRIMARY
	WELL 3- SUPPLEMENTAL
	WELL 1- PRIMARY
	WELL 4- PRIMARY

Application No. G-9385 Permit No. G-9311.....
IN NAME OF

JACK L. GILLETTE.....

Surveyed OCT. 28, 1981, by L.T.OLL.....