


G. 1224

35867 -CW
75836
T8628

T.27S.R.17&18E.W.M.

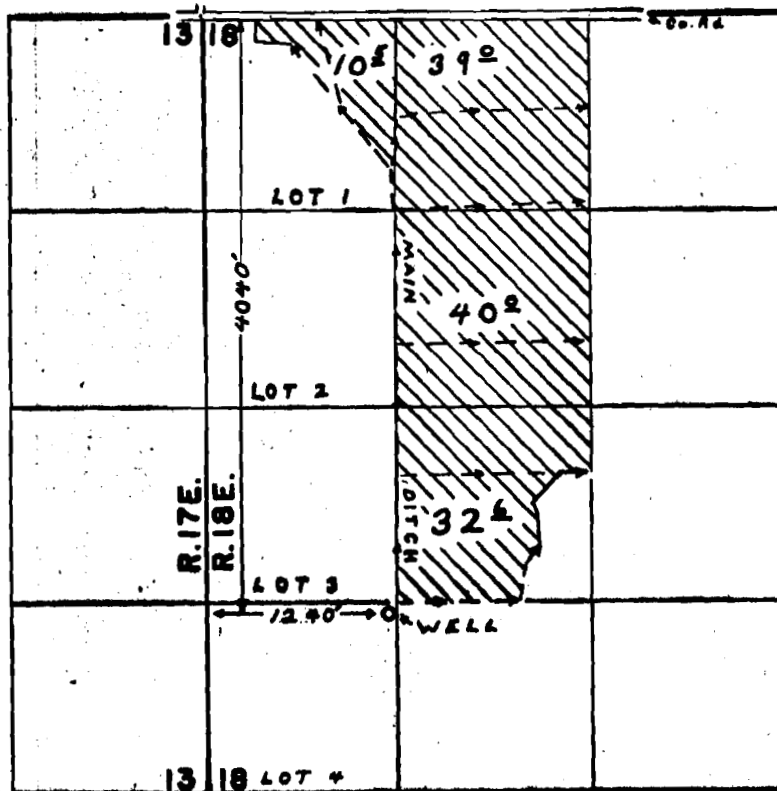

FINAL PROOF SURVEY
UNDER

Application No. 8-1326. Permit No. 8-1224.
IN NAME OF

JACK L. and E. CATHERINE GILLETTE

Surveyed AUG. 7. 1968, by L. E. SOULD