


C7-6261
T8028
46679
75831
T8028

T.27S.R.18E.W.M.

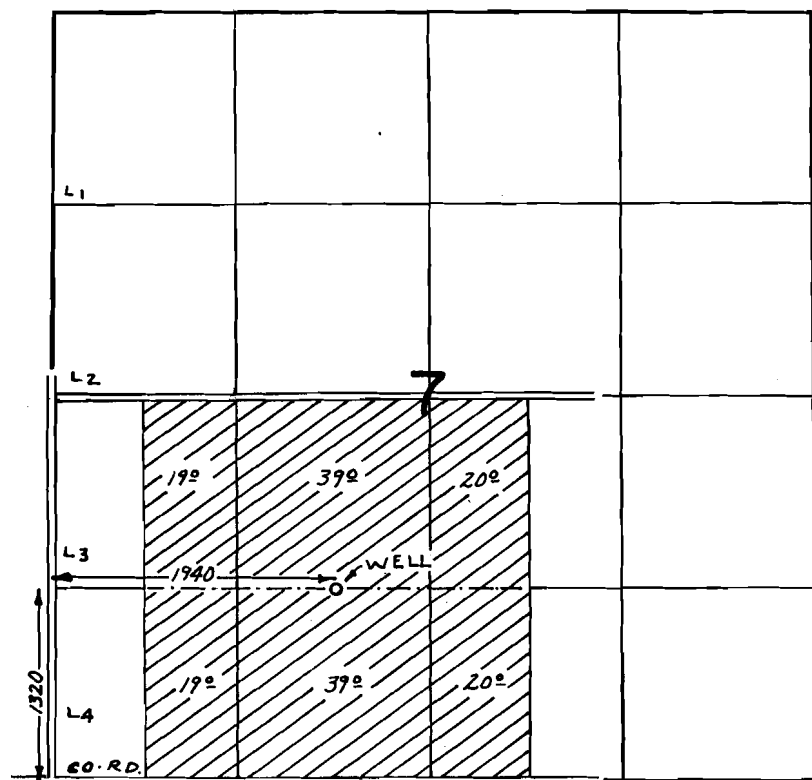

FINAL PROOF SURVEY
UNDER

Application No. G-6731 Permit No. G-6261
IN NAME OF

JACK L. GILLETTE

Surveyed DEC. 26, 1976, by R. MUCKEN