T. 9S. R. 1 W. W. M.

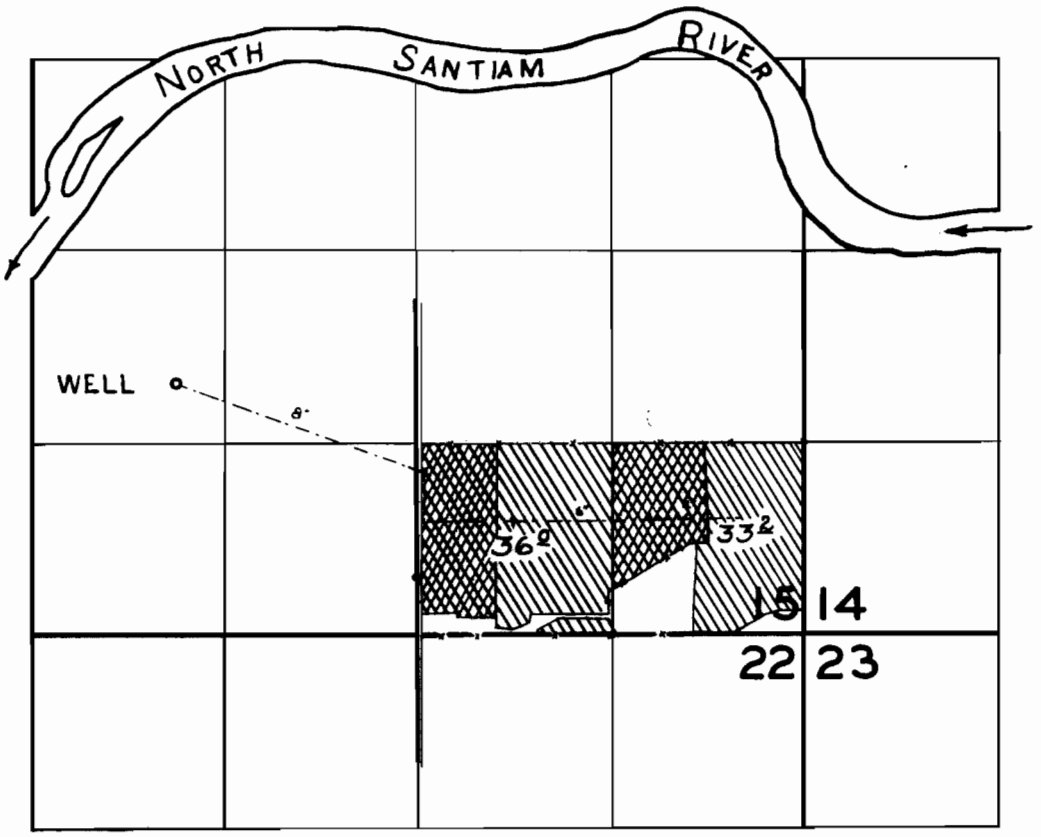

FINAL PROOF SURVEY
UNDER

PRIMARY SUPPLEMENTAL

Application No. G-1389 Permit No. G-1255
IN NAME OF

CARL BETHELL

Surveyed JULY 7 1960, by M. BISH

1960 D