


T. 38 S., R. 3 W., W.M.

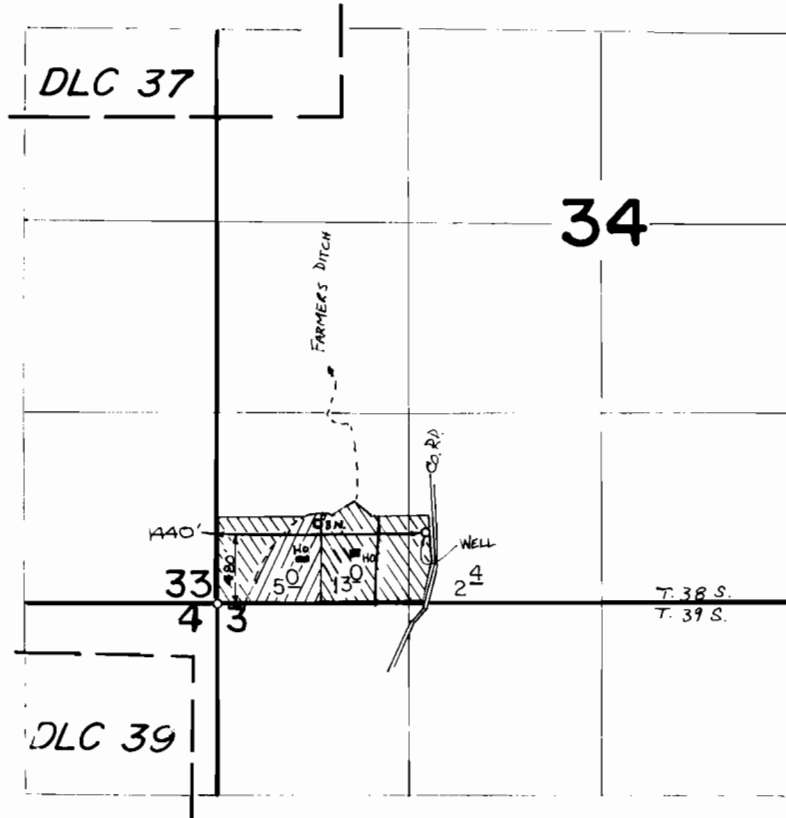

Supplemental
Primary

FINAL PROOF SURVEY UNDER

Application No. G.9142... Permit No. G.8515.....
IN NAME OF

CHARLES "COLLIE" WELLS

Surveyed APRIL 21, 1982, by B. R. SUND.....