


RECEIVED

FEB 28 2000

T. 38 S., R. 3 W., W. M.

WATER RESOURCES DEPT.
SALEM, OREGON

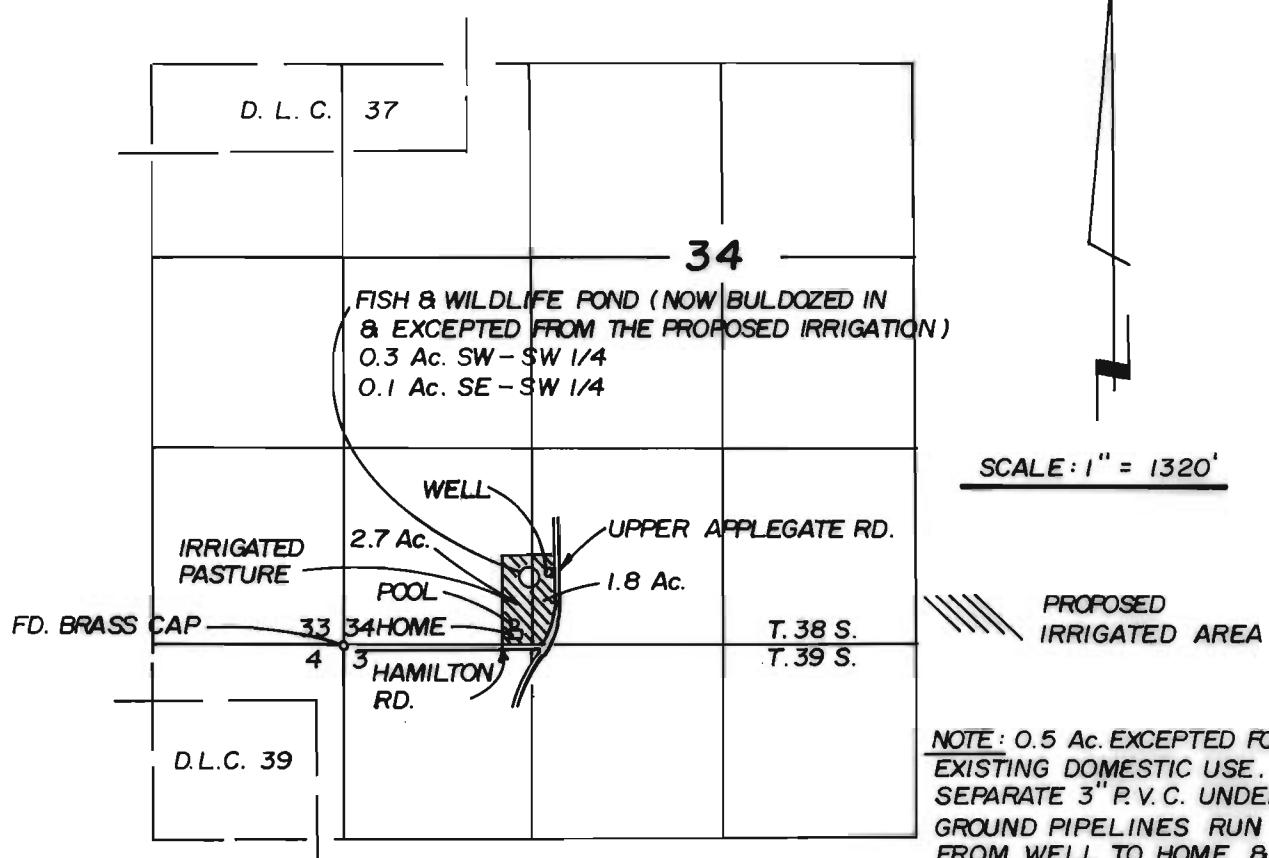

FINAL PROOF SURVEY
FOR TRANSFER NO. 8034


NOTE: THIS MAP HAS BEEN PRE-
PARED FOR WATER RIGHT PUR-
POSES ONLY, NOT FOR BOUNDARY
LOCATIONS.

APPLICANT


ANDREW & REBECCA JOFFER
20 HAMILTON RD.
JACKSONVILLE, OR. 97530

TL 700 38 3W 34

MAP PREPARED FEBRUARY 16, 2000 BY MARK E. BOYDEN

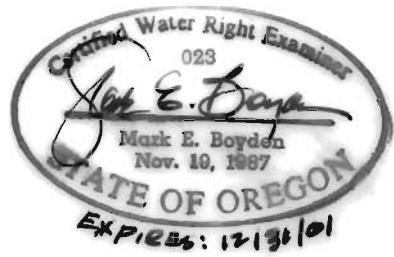

T. 38 S., R. 3 W., W.M.

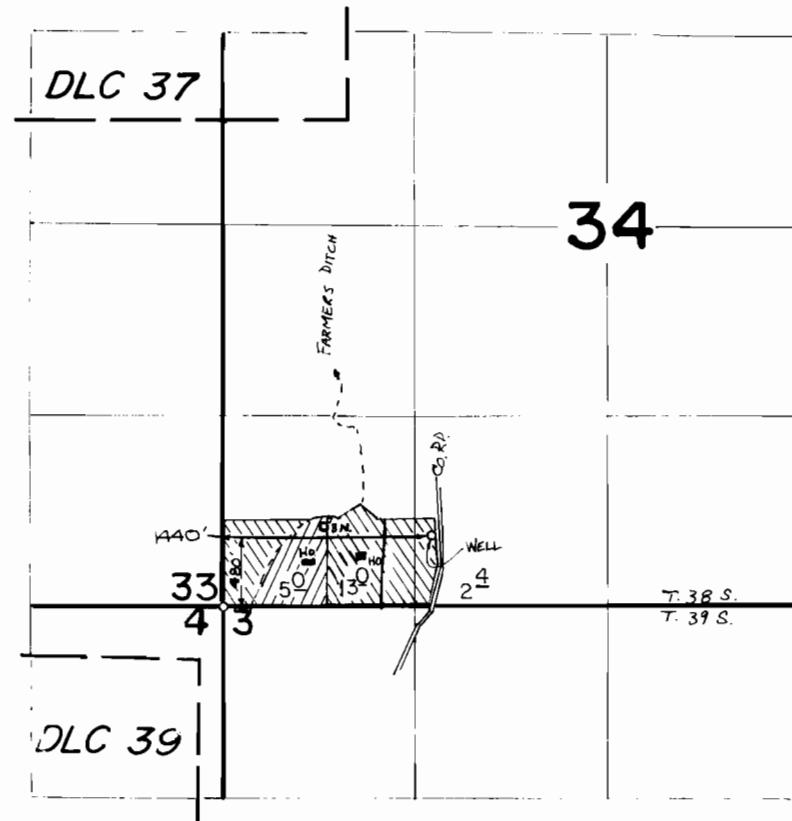

FINAL PROOF SURVEY
UNDER

Application No. G.9142... Permit No. G.8515.....
IN NAME OF

CHARLES "COLLIE" WELLS

Surveyed APRIL 21, 1982., by B. R. SUND.....