


T. 29 S. R. 4 W. WM.

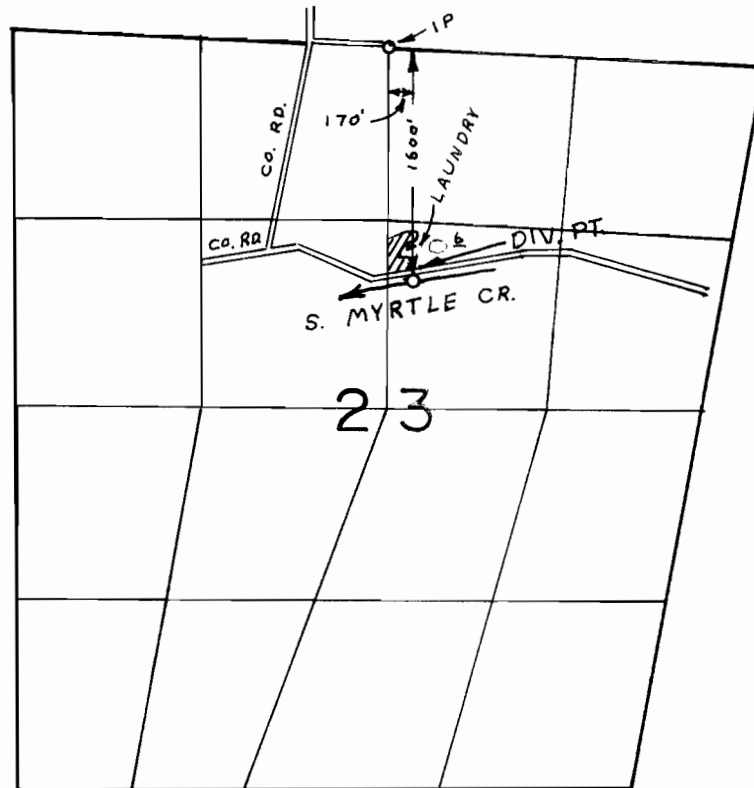

FINAL PROOF SURVEY
UNDER

Application No. 46886 Permit No. 35055
IN NAME OF

MICHAEL D. BROCHU

Surveyed JULY 9 1974, by L. H. NUNN