


T.7S.R.19E.W.M.

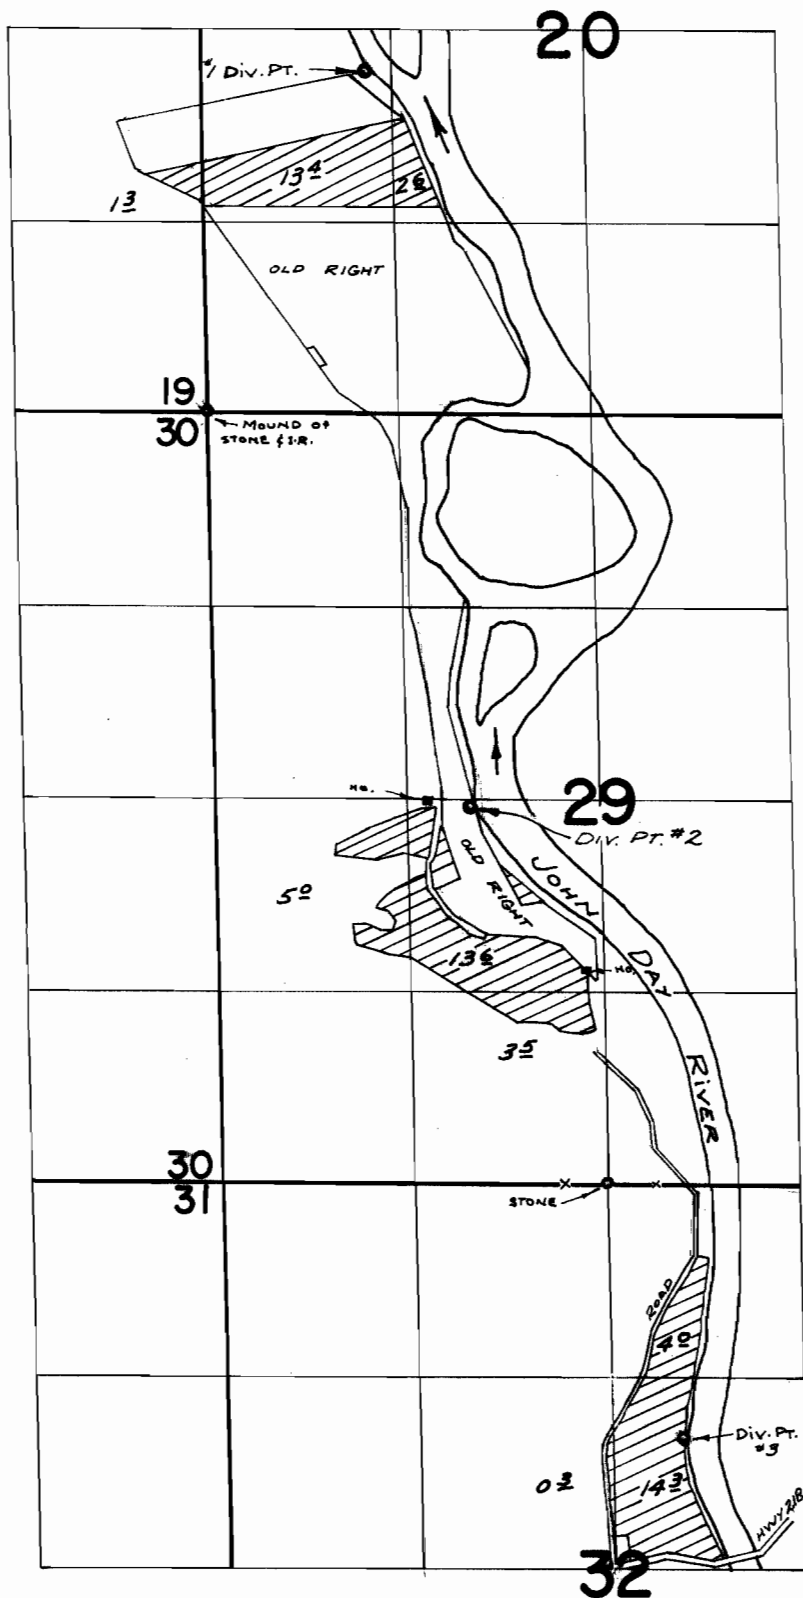

FINAL PROOF SURVEY

UNDER

Application No. 33448 Permit No. 26435

IN NAME OF

**FRANK I. & EDNA JUNE THOMPSON**

Surveyed Oct 31 1962, by THOMAS R. LAUER