


6789

Tract 2 North Range 12 E.O.D. 1912

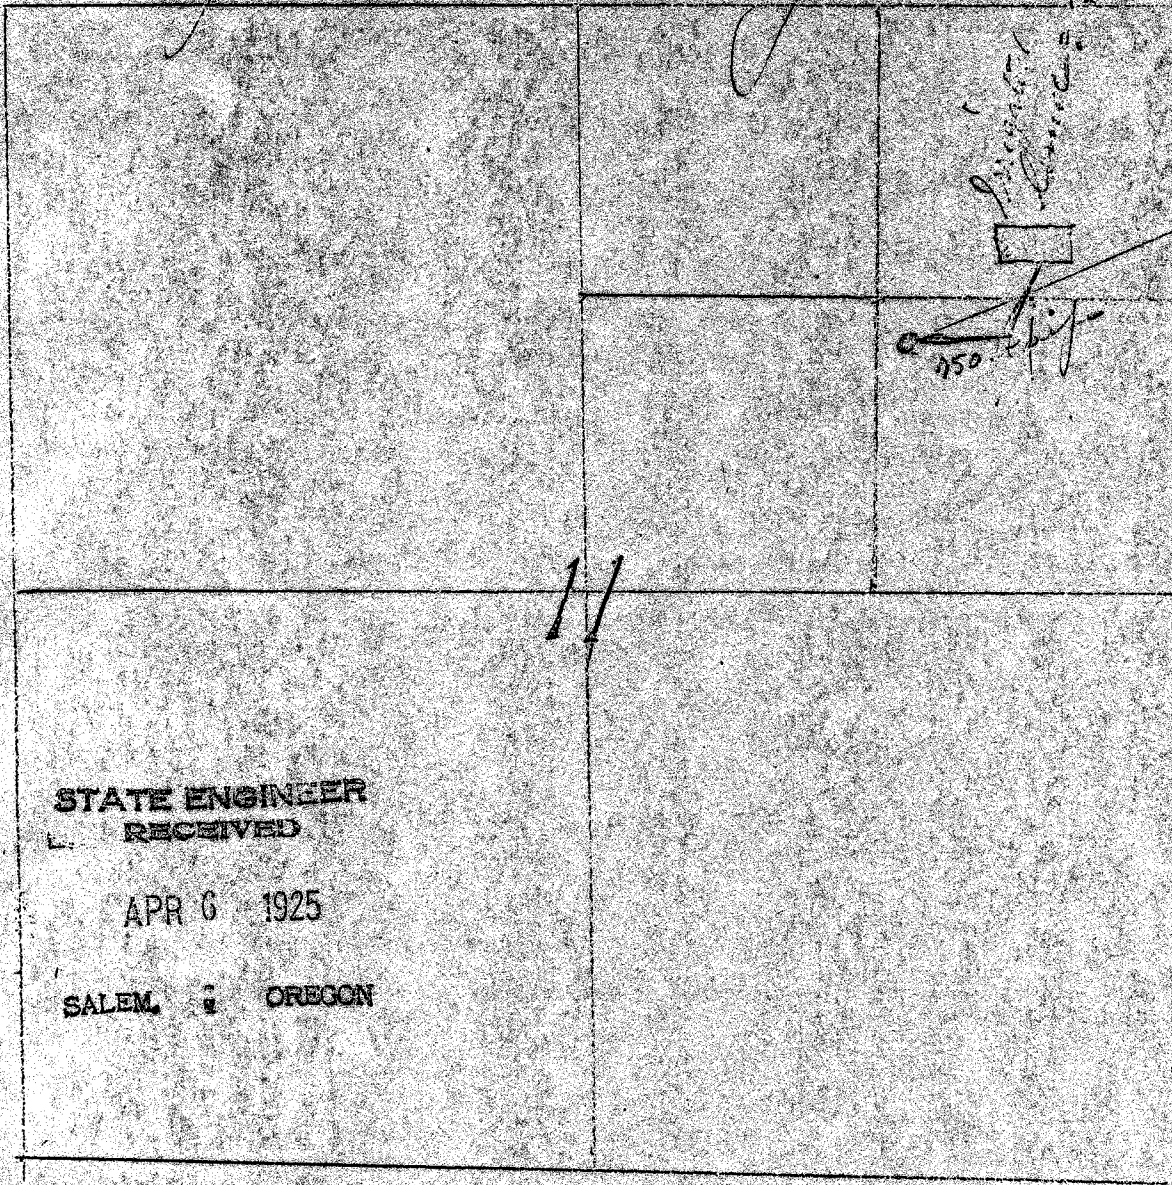

STATE ENGINEER  
RECEIVED

APR 6 1925

SALEM, OREGON

Application No. 10092  
Permit No. 6789