


8-2115

32697
75844

T.6N.R.34E.W.M.

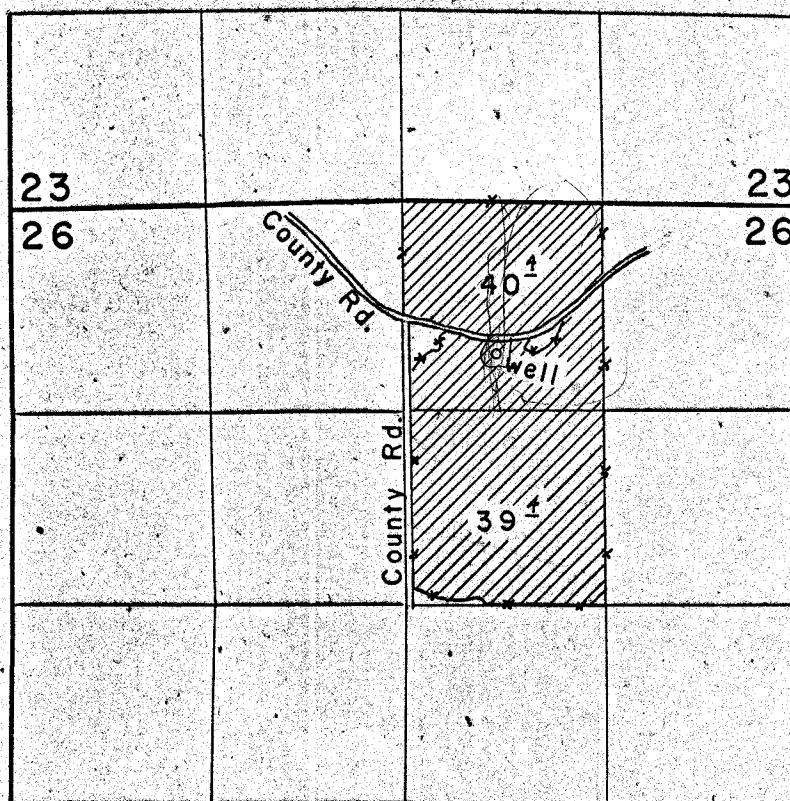

FINAL PROOF SURVEY
UNDER

Application No. G-2293. Permit No. G-2115...
IN NAME OF

L.M. Marlatt & Lowell W. Marlatt

Surveyed Aug. 25, 1964, by C.J. Gardner...