


T.9S., R.45E., W.M.

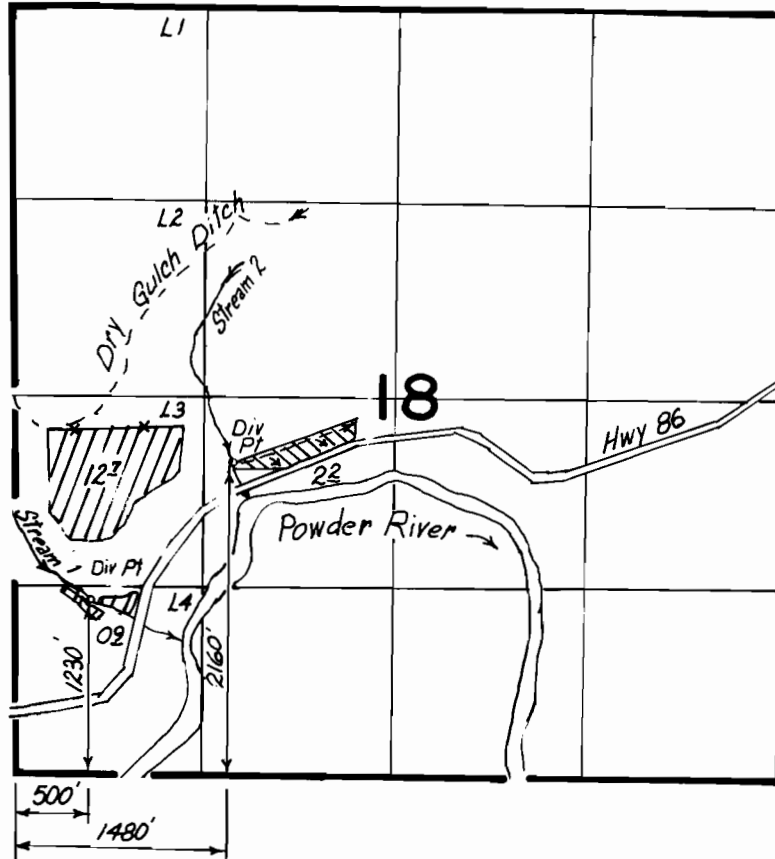

Scale: 1" = 1320'

FINAL PROOF SURVEY UNDER

Application No. 62934 Permit No. 47674
IN NAME OF

LEONARD KNIGHT

Surveyed 10-4 1988, by Kenn Kemp

- Stream 1 Irrigation
- Stream 2 Irrigation