

MAP

Accompanying Application For Permit To appropriate Water.

Rhea Luper - State Eng'r


Scale 2,17 = 1, mi.

CERTIFICATE OF REGISTERED PROFESSIONAL ENGINEER.

I, Robert A. Dean, of Portland, Oregon, do hereby certify that this map was made from notes taken during an actual survey made under my immediate supervision on June 30, 1925 and that it correctly represents the works described in the accompanying application, together with streams and other ditches in immediate vicinity.

Robert A. Dean
Registered Professional Engineer
Oregon, No 138
Nov. 8, 1919
OREGON
NOV. 8, 1919
ROBERT A. DEAN

Twp 3, S. R4N, W.M.

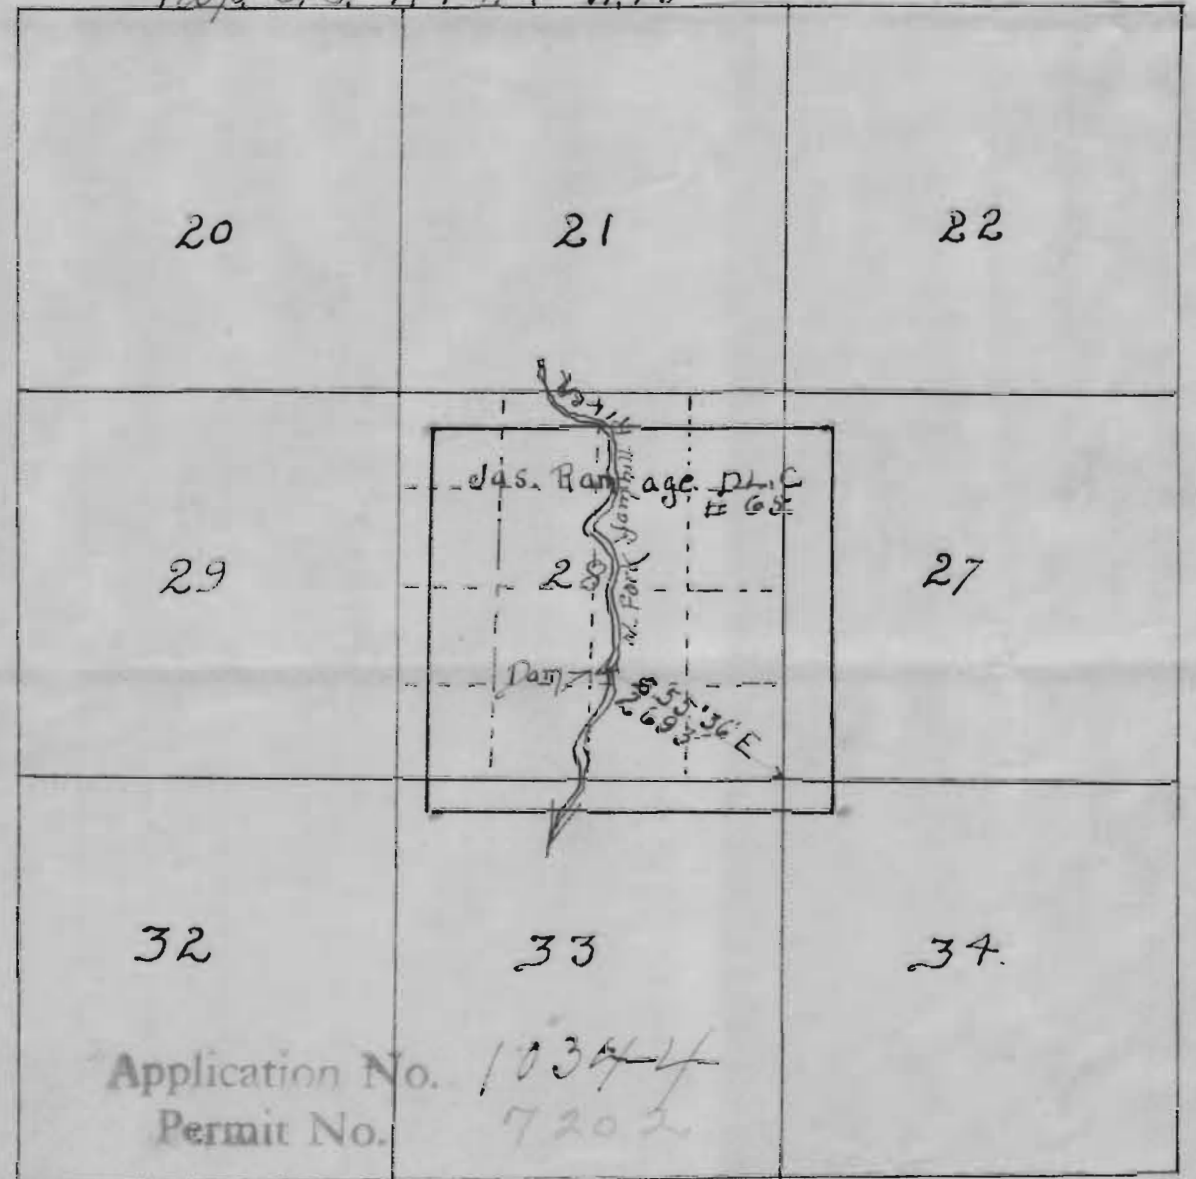

STATE ENGINEER
RECEIVED

AUG 17 1925

SALM. OREGON

10344