


T.6S.,R.1W.,W.M.

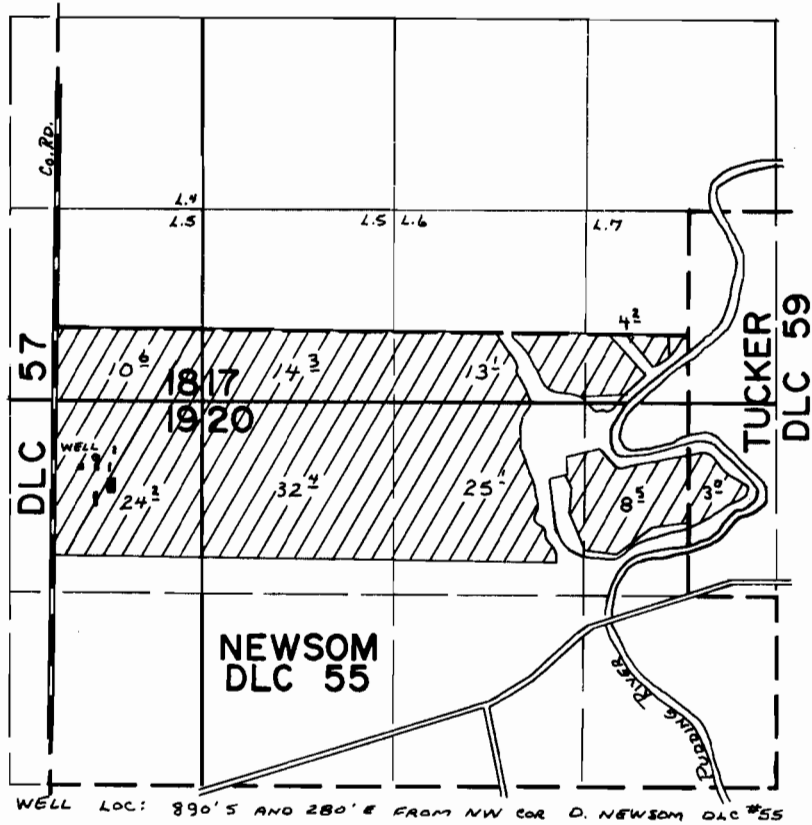

FINAL PROOF SURVEY UNDER

Application No. G-5441 Permit No. G-5359
IN NAME OF

ALAN OBERSINNER

Surveyed Oct. 1 1975, by L. Toll