


Tax Lot No. 23 12 29BD TL1900

Section 29 Township 23S Range 12W W.M.  
Coos County

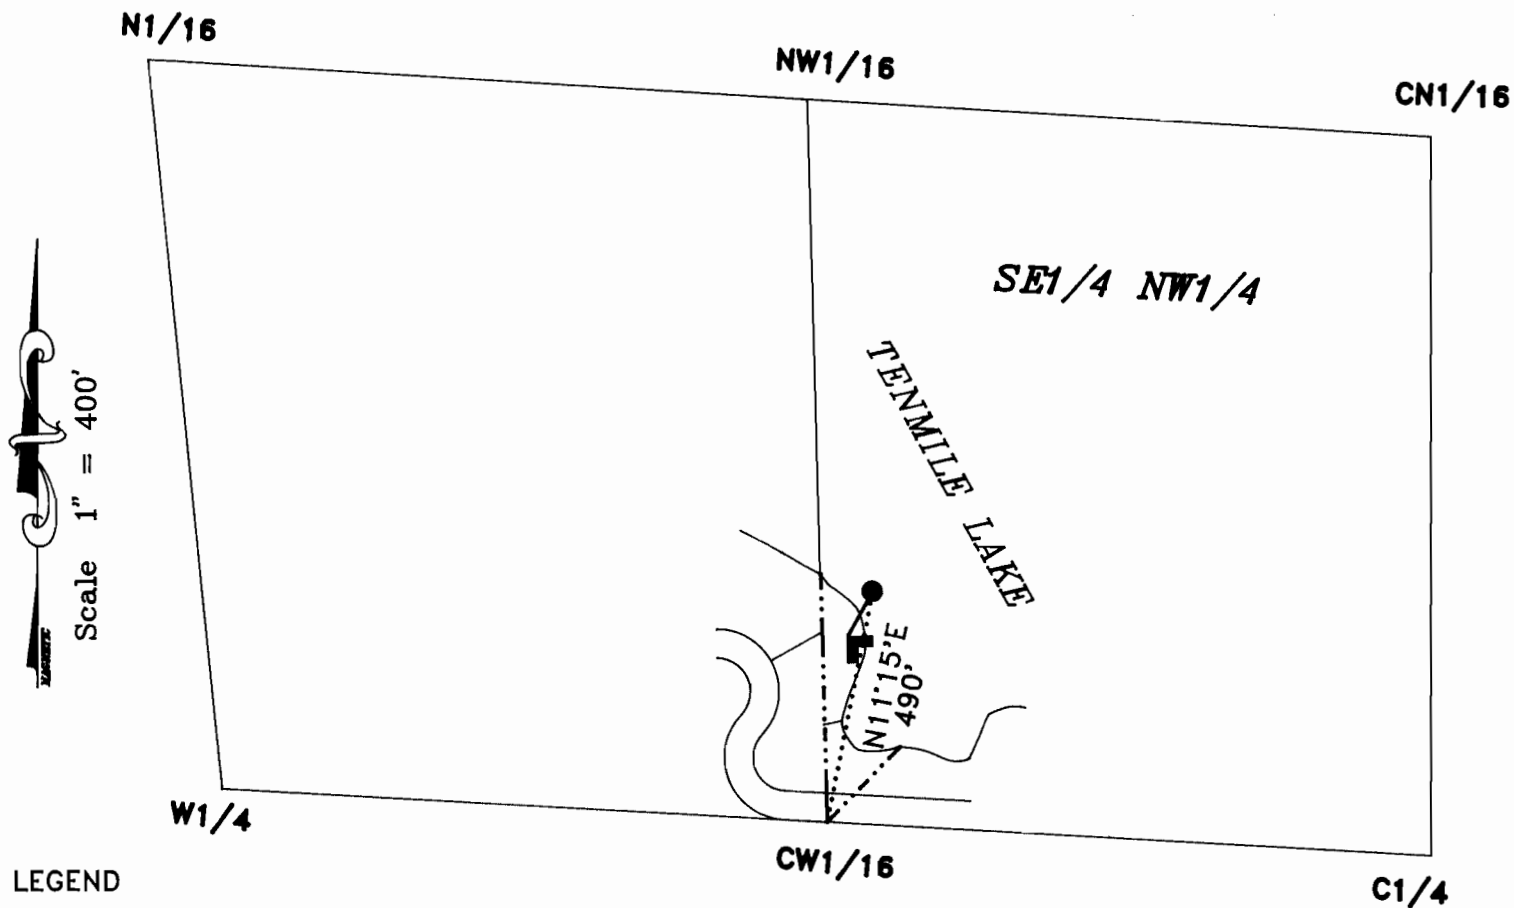


LEGEND

- HOME
- POINT OF DIVERSION
- WATERLINE
- - - - - PROPERTY LINE

EXAMINERS DISCLAIMER STATEMENT

The preparation of this map was for the purpose of identifying the location of the Water Right only and has no intent to provide dimensions or location of property ownership lines.

**FINAL PROOF SURVEY**  
IN THE NAME OF  
Merle Loomis

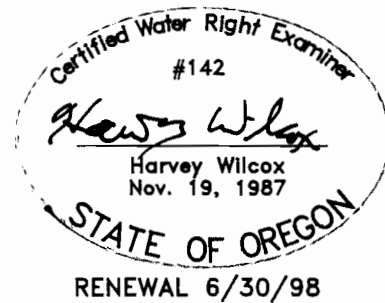

Surveyed on 2/19/98 by H.A. Wilcox

Application No. S-80910  
Permit No. 53049