


T.39 S., R.2 W., W.M.

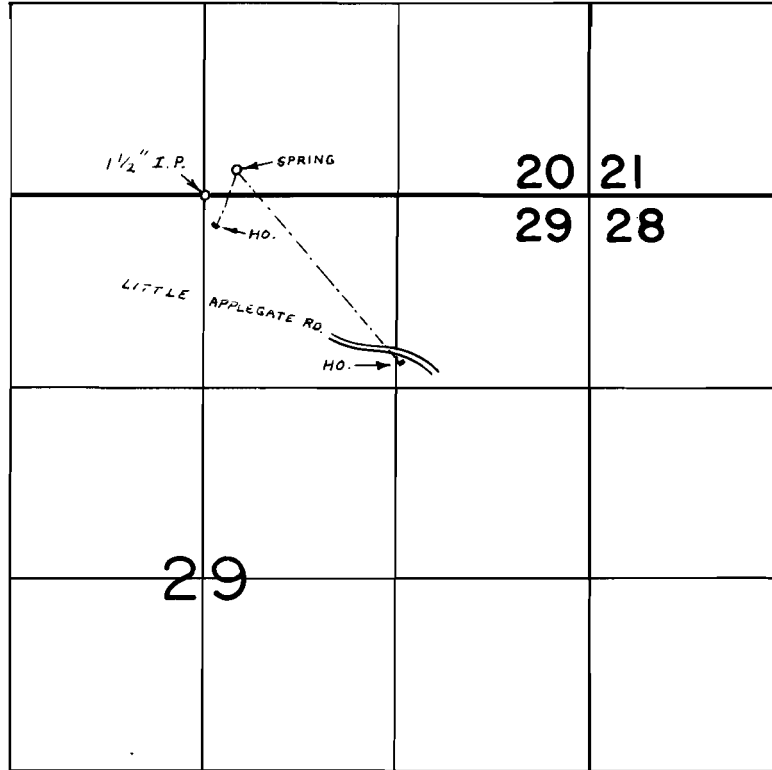

SPRING LOC. : 170' N. & 220' E. FROM S 1/4 COR. SEC. 20

FINAL PROOF SURVEY UNDER

Application No. 53203 Permit No. 39479

IN NAME OF

VIEVA SALT MARSH

Surveyed OCT. 9 1978, by B. SUND