


T.2S. R.2W. W.M.

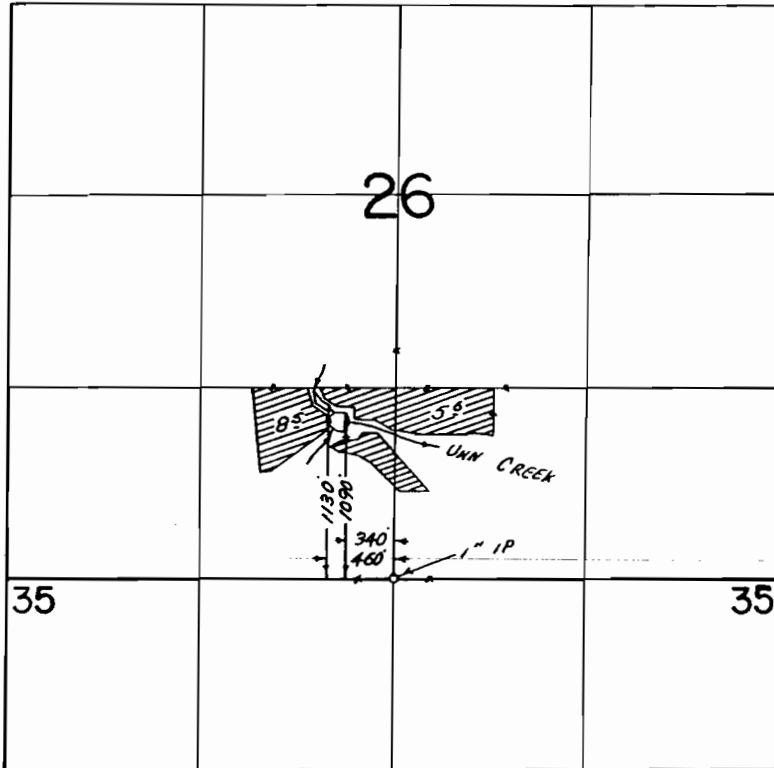

FINAL PROOF SURVEY

UNDER

R-38892

R-3420

38893

28955

R-45417

R-5367

Application No.45418. Permit No.33903

IN NAME OF

TOM DENISON

Surveyed May...17.. 1974, by R...G...MUCKEN