


G-9077

56227

75883

T 8059

T.27S., R.16E., W.M.

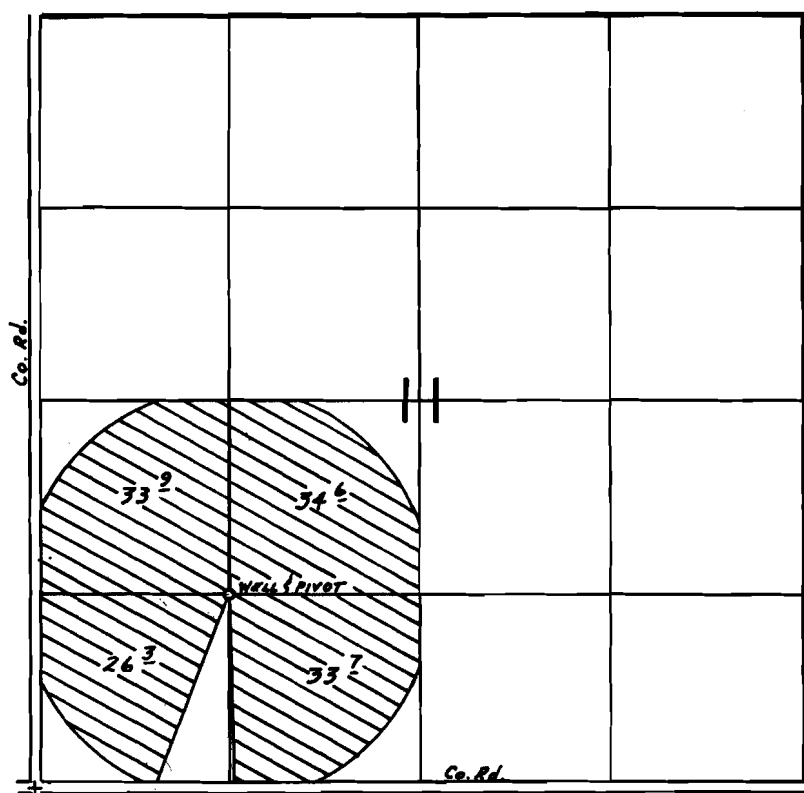

WELL LOC: 1310' N. & 1310' E. FROM SW COR. SEC. 11

SCALE: 1" = 1320'

FINAL PROOF SURVEY UNDER

Application No. G-9978. Permit No. G-9077.....
IN NAME OF

.....ROBEY RANCHES.....

Surveyed OCT. 31... 1984, by R.W. BISHOP.....