


T. 38 S., R. 14 W., W. M.

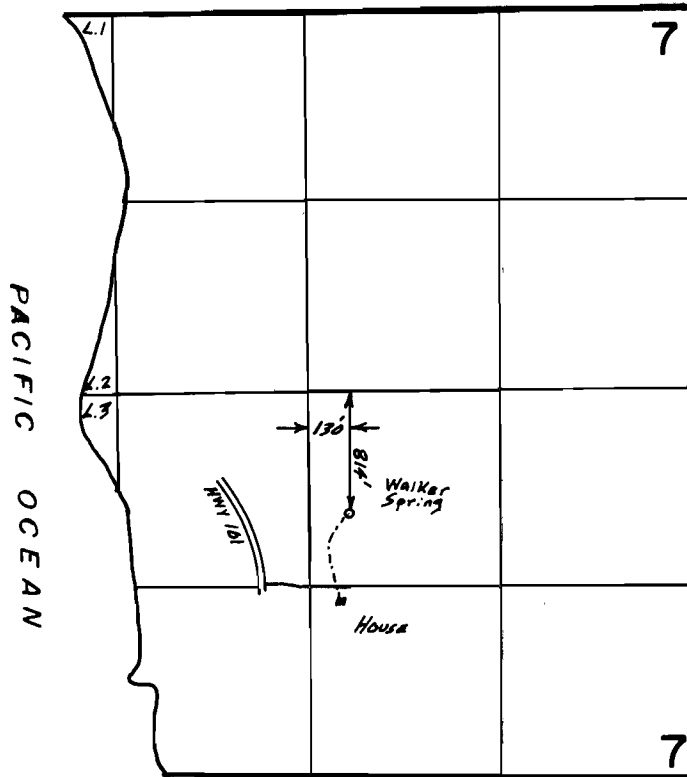

Scale 1" = 1320'

FINAL PROOF SURVEY
UNDER

Application No. ~~66052~~ Permit No. ~~48074~~...
IN NAME OF

Laurie Wynn Johnson.....

Surveyed Sept. 26, 1991, by B. S. James...
Oct. 21, 1991