


48338

T. 38 S., R. 14 W., W. M.

RECEIVED

OCT 16 1998

WATER RESOURCES DEPT.  
SALEM, OREGON

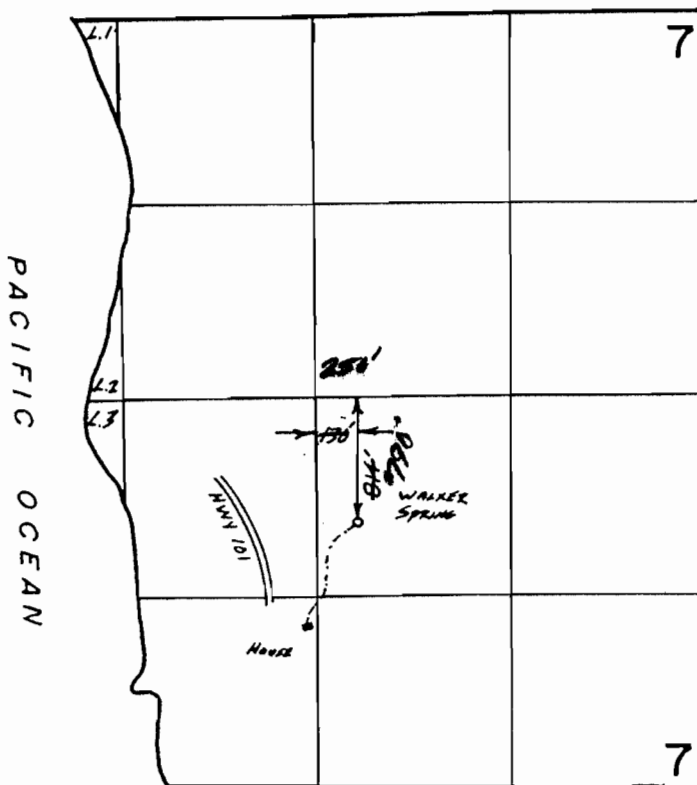

Scale : 1" = 1320'

**FINAL PROOF SURVEY**  
UNDER

Application No. 66959 Permit No. 48338...  
IN NAME OF

GERALD DENIS & SHAO ANN ALGOZER

Surveyed Sept. 26, 1991, by B.S. JAMES

Oct. 21, 1991

Revised 10/6/98