


T. 1 S., R. 4 E., W.M.

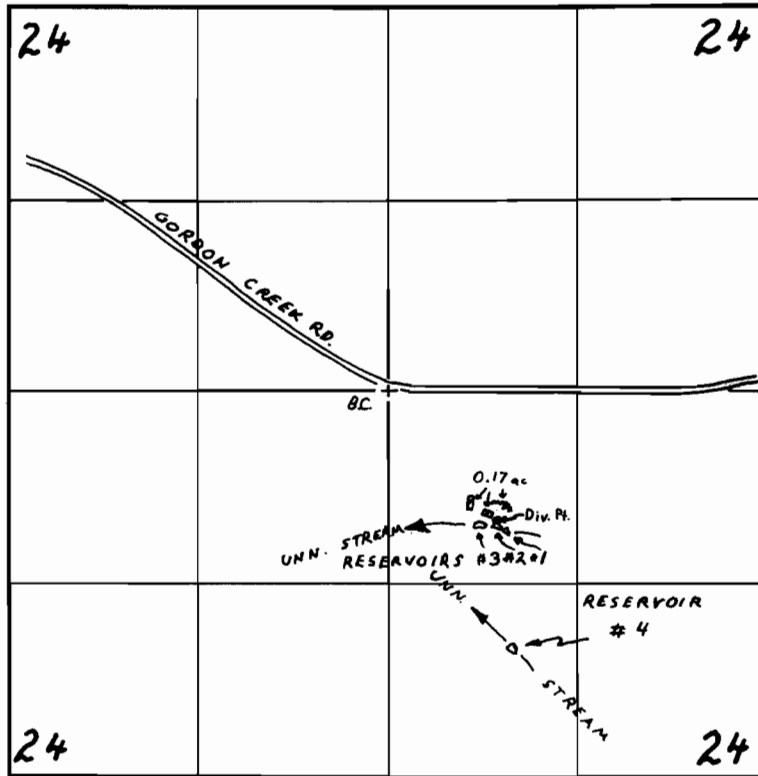

RESERVOIR LOCATIONS: 1 - 960' S & 810' E; 2 - 920' S & 720' E;
3 - 930' S & 590' E; 4 - 1750' S & 840' E ALL LOCATED
FROM THE CENTRA 1/4 CORNER SECTION 24

FINAL PROOF SURVEY UNDER

Application No. R-68429, 68430 Permit No. R-10511, 49440
IN NAME OF

RANDOLF G. HAGER

Surveyed 8/13/93-R.W. Klassen, 8/26/98-P.K. Starnes